


T.27S. R.15E., W.M.

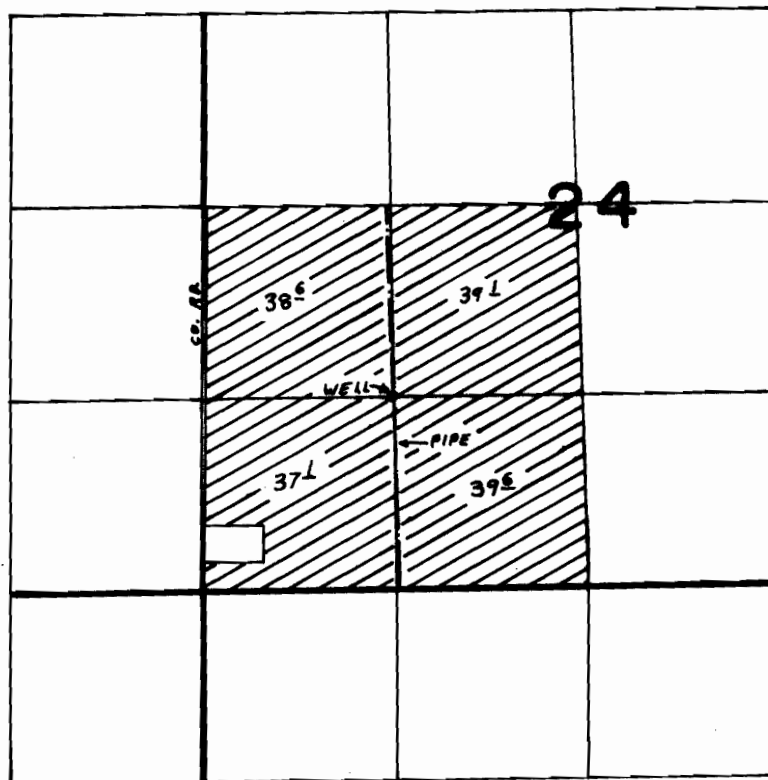

WELL LOC. 1320' N. + 1290' E. FROM S.W. COR SEC. 24

FINAL PROOF SURVEY
UNDER

Application No. G-6303... Permit No. G-5925...
IN NAME OF

.....DARREL G. BOWEN.....

Surveyed JUL 18, 1977, by D.M. NORBY.....