T. 11 S. R. 2 W.W.M.

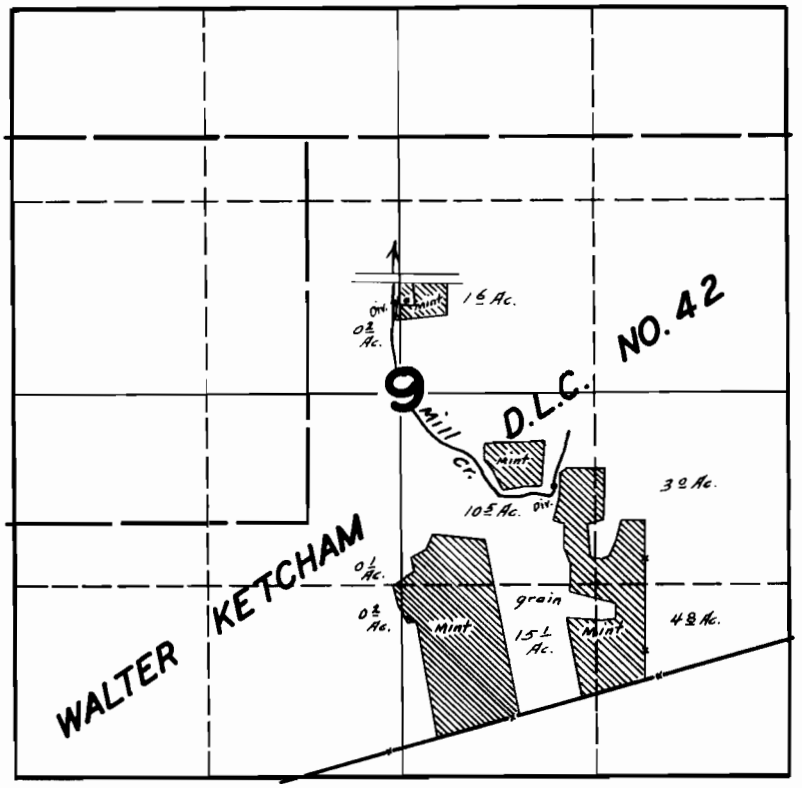

FINAL PROOF SURVEY

UNDER

Application No. 16474 Permit No. 12278

IN NAME OF

H. E. MULLEN

Surveyed JULY 26 1945, by [illegible]

1945-B