


T.14S.R.4W.W.M.

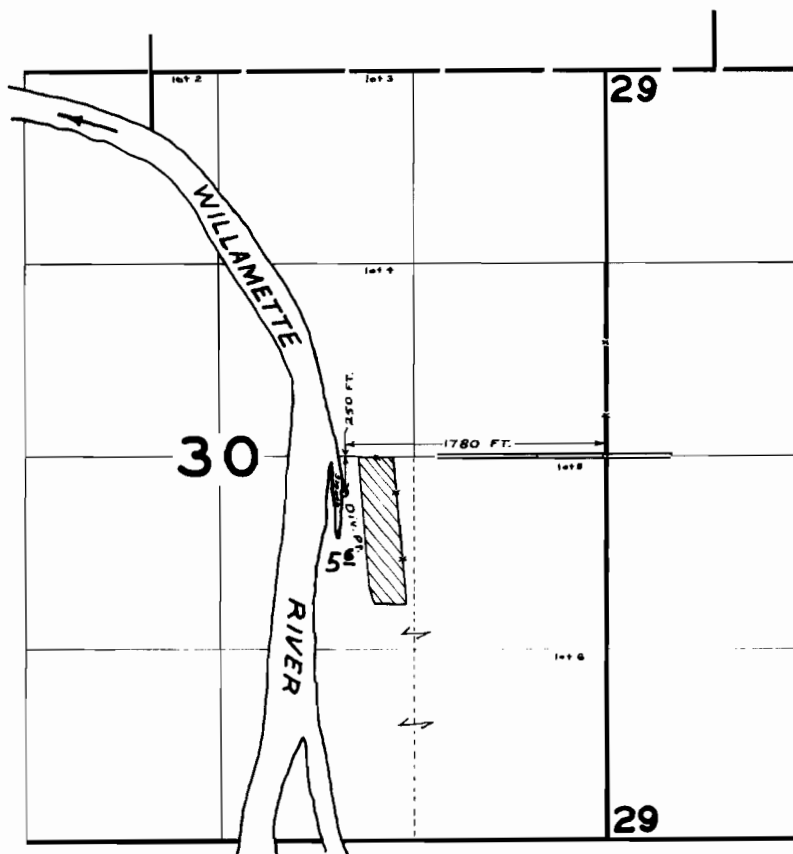

FINAL PROOF SURVEY
UNDER

Application No. 37564 Permit No. 27988
IN NAME OF

GEORGE P. HARGETT

Surveyed Oct 12 1965, by R. JACKSON