


# T. 11 S., R. 4 W., W.M.

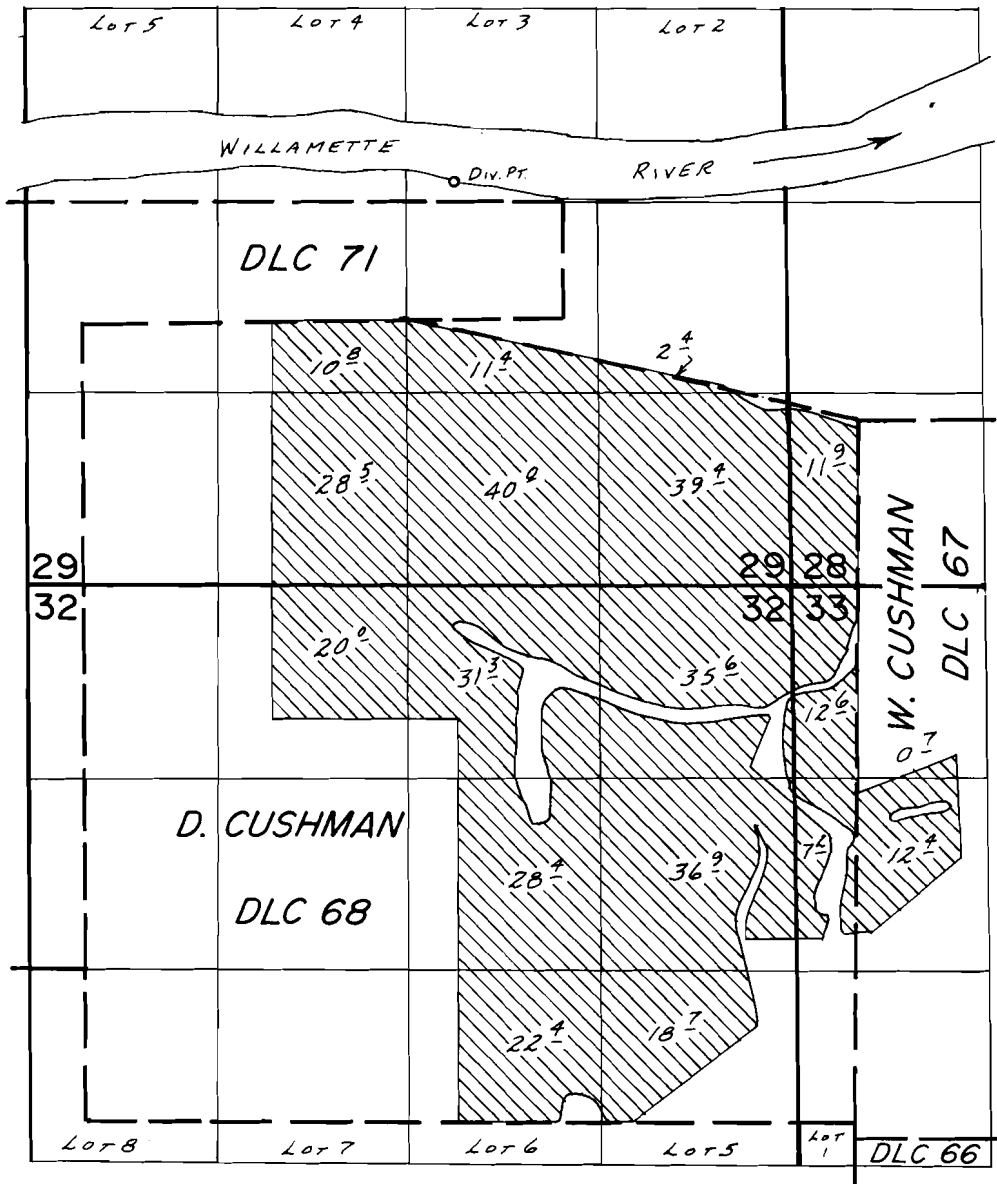

SCALE: 1"=1320'

Div. Pt. Loc.: 2760' N. & 330' E. FROM 5/4 COR. SEC. 29

## FINAL PROOF SURVEY UNDER

Application No. 60359. Permit No. 45084....  
IN NAME OF

EDSEL CHASE & SONS FARMS, INC.

Surveyed May 14, 1986, by B.W. BISHOP.....

11/4/86  
BWB.