


T.14S., R.4W., W.M.

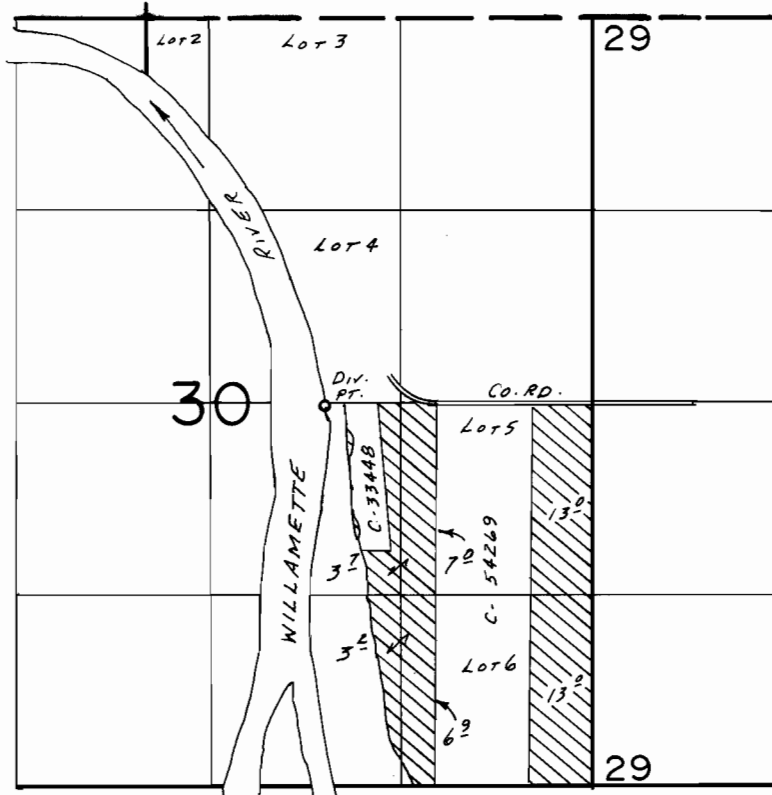

DIV. PT. LOC.: 2610' N. & 1840' W. FROM SEC. COR. SEC. 30

SCALE: 1" = 1320'

FINAL PROOF SURVEY UNDER

Application No. 68673. Permit No. 49688....
IN NAME OF

LARRY C. KROFF

Surveyed Sept. 22, 1986, by B.W. BISHOP

11/6/86
BWB