


T. 11 S., R. 2 W., W. M.

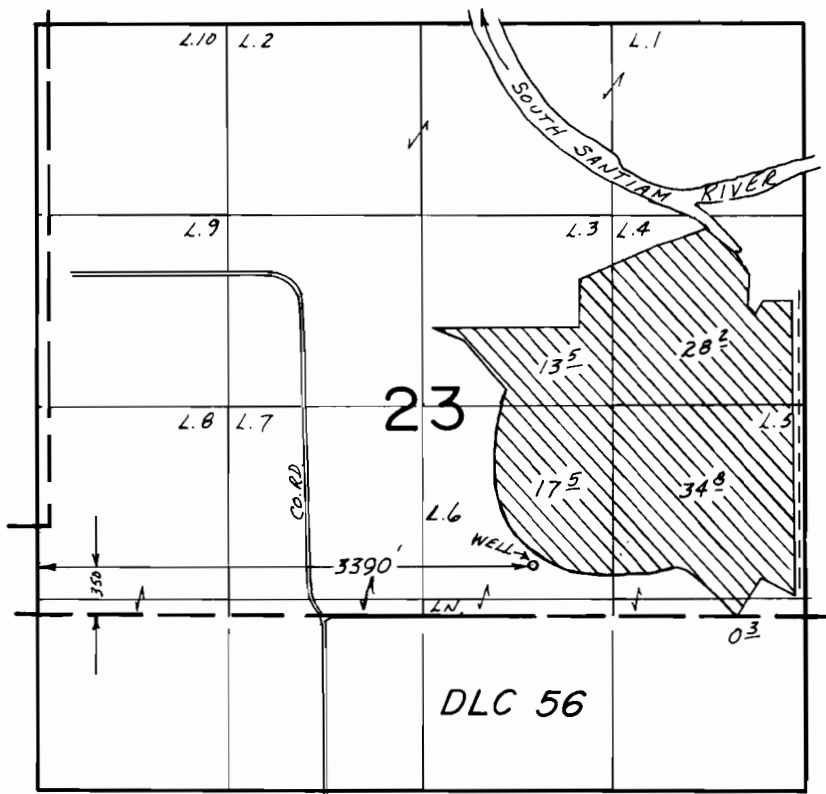

SCALE: 1" = 1320'

FINAL PROOF SURVEY
UNDER

Application No. G-8138.. Permit No. G-7509....
IN NAME OF

ROBERT MEYER

Surveyed MAY 27, 1982, by L. M. TOLL
MAY 13, 1986 B. W. BISHOP

11/3/86
BWB

PTS 1986-B
PTS 1982-Z RBWB