


T9S R1E WM

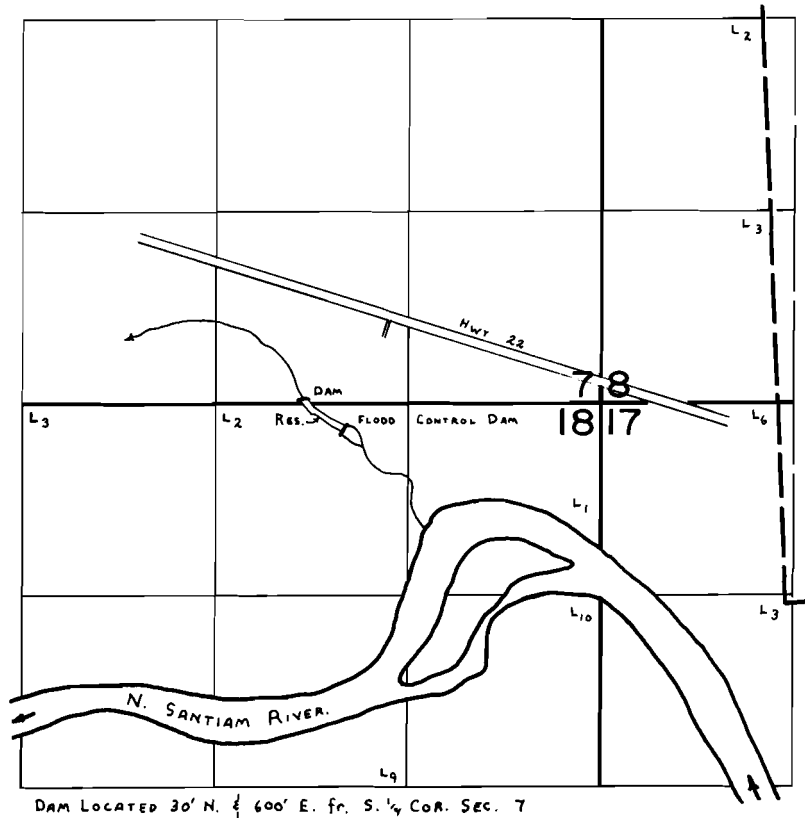

FINAL PROOF SURVEY UNDER

R-55188 R-6602
Application No. ~~55188~~ Permit No. ~~41609~~.....
IN NAME OF

BEN BRANDON

Surveyed Apr. 24 1980, by C. L. HUGHES