


T9S R1E WM

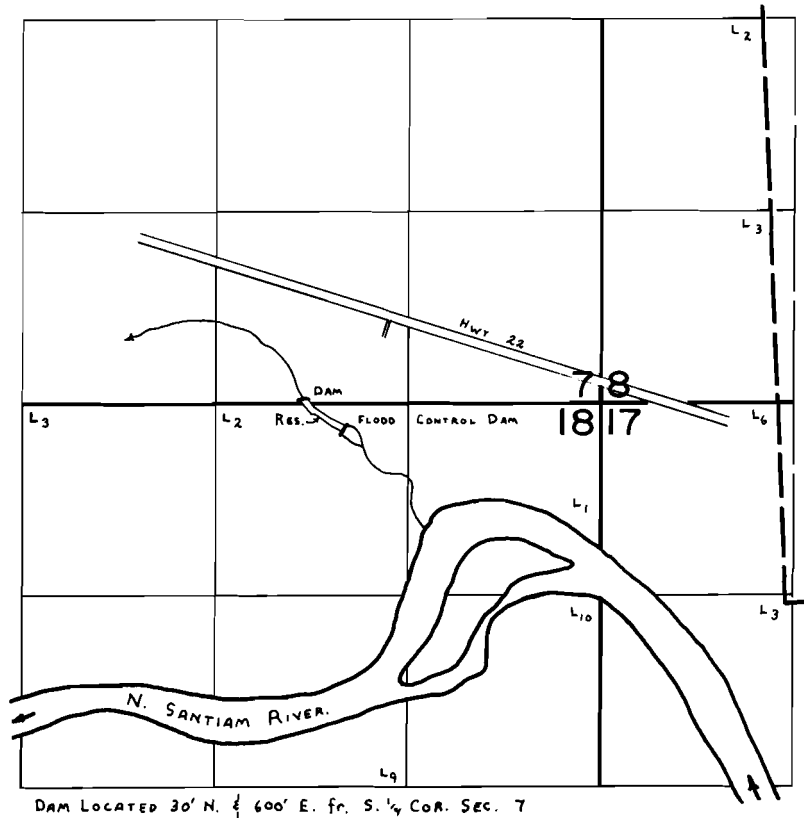

FINAL PROOF SURVEY UNDER

R-55188 R-6602
Application No. ~~55188~~... Permit No. ~~41609~~.....
IN NAME OF

..... BEN BRANDON

Surveyed Apr. 24..... 1980., by C. L. HUGHES.....