


T. 7 & 8 S., R. 2 W., W.M.

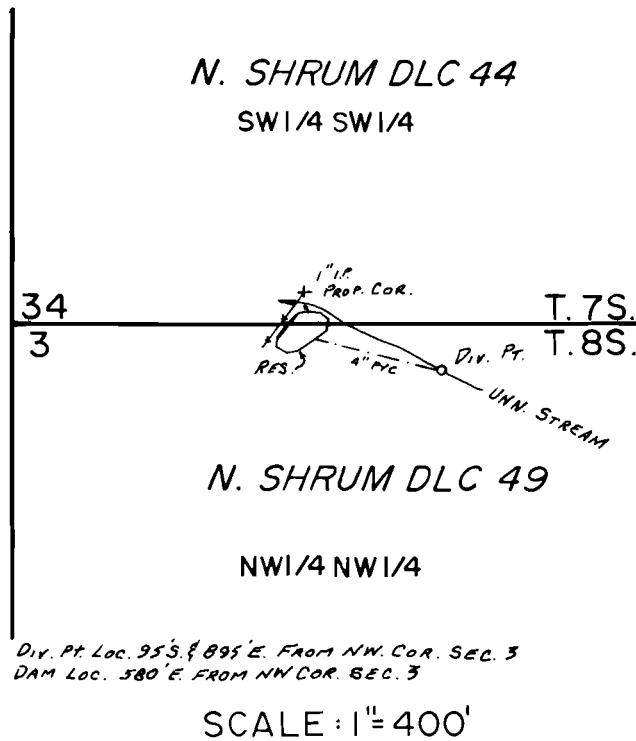

FINAL PROOF SURVEY
UNDER

R-57915 R-7712
Application No. 57916..... Permit No. 43609.....
IN NAME OF

.....WINTHROP G. MILLER.....

Surveyed APR. 28, 1980, by C.L. HUGHES.....