


T. 6S. R. 1E. W.M.

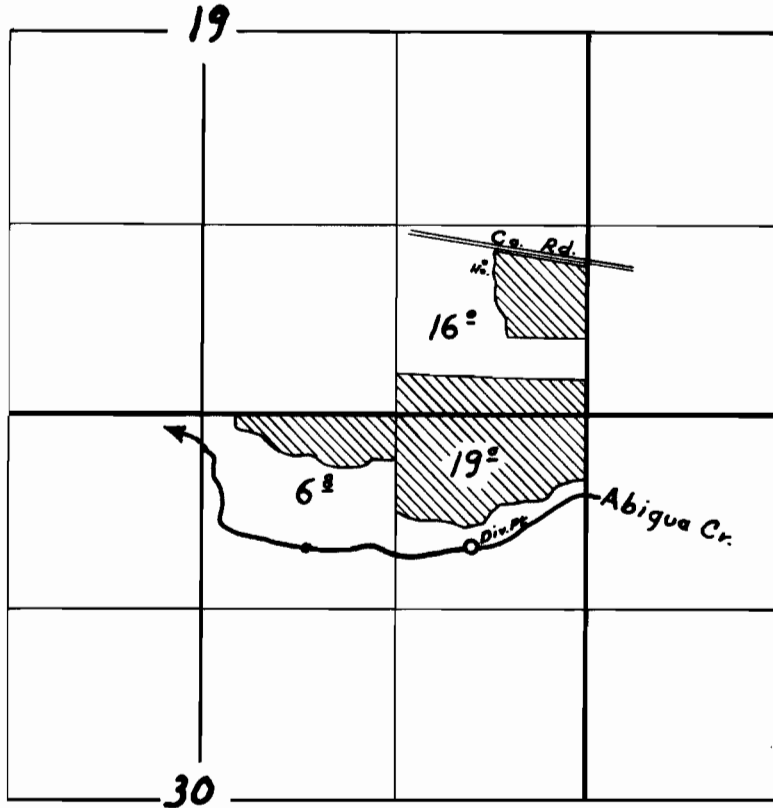

FINAL PROOF SURVEY

UNDER

Application No. 25197 Permit No. 19957

IN NAME OF

L. P. OEHLER

Surveyed 19 July 1956, by M. Bish

DFN-1D-124

MB