


T.9S. R.3W. W.M.

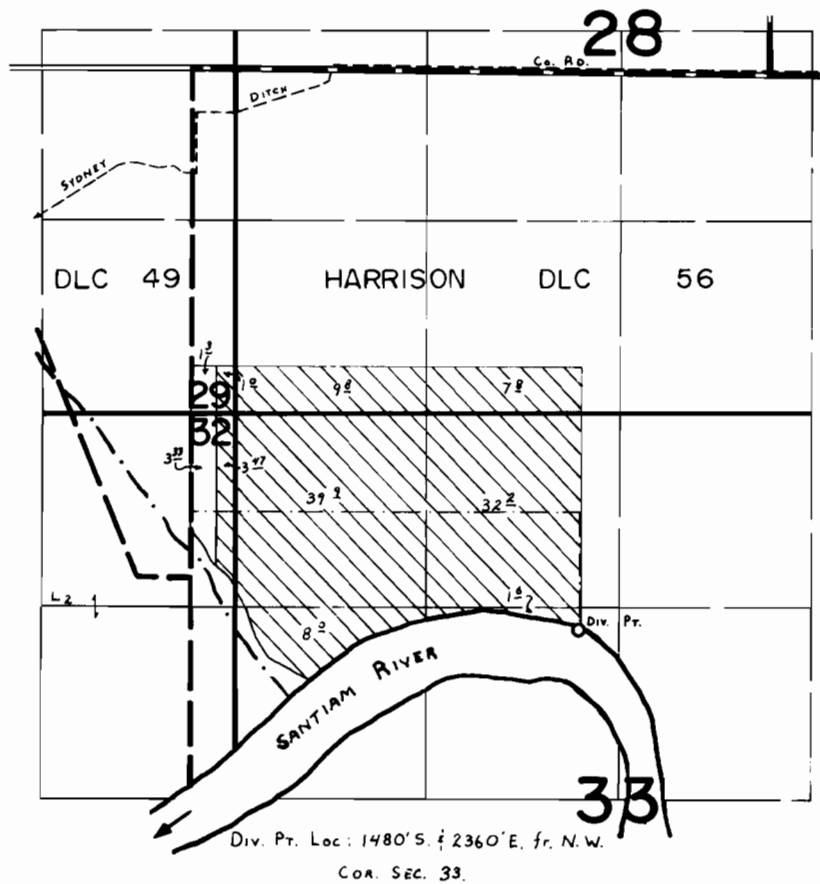

FINAL PROOF SURVEY
UNDER

Application No. 51767 Permit No. 38197
IN NAME OF

WILLAMETTE ESSENTIAL OILS, INC.

Surveyed AUG. 31. 1979, by S. C. BROWN