


T.5S.,R.2W.,W.M.

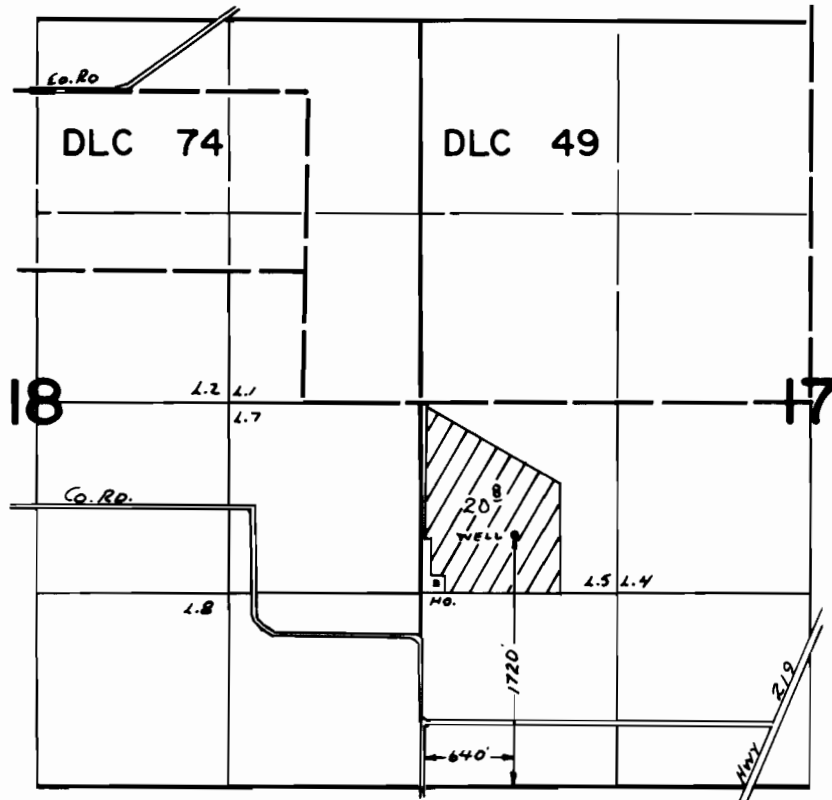

FINAL PROOF SURVEY
UNDER

Application No. G-5830. Permit No. G-5577.
IN NAME OF

SAMUEL A. SHEPARD

Surveyed APRIL 2, 1976, by L. Toll