


T7S R2W WM

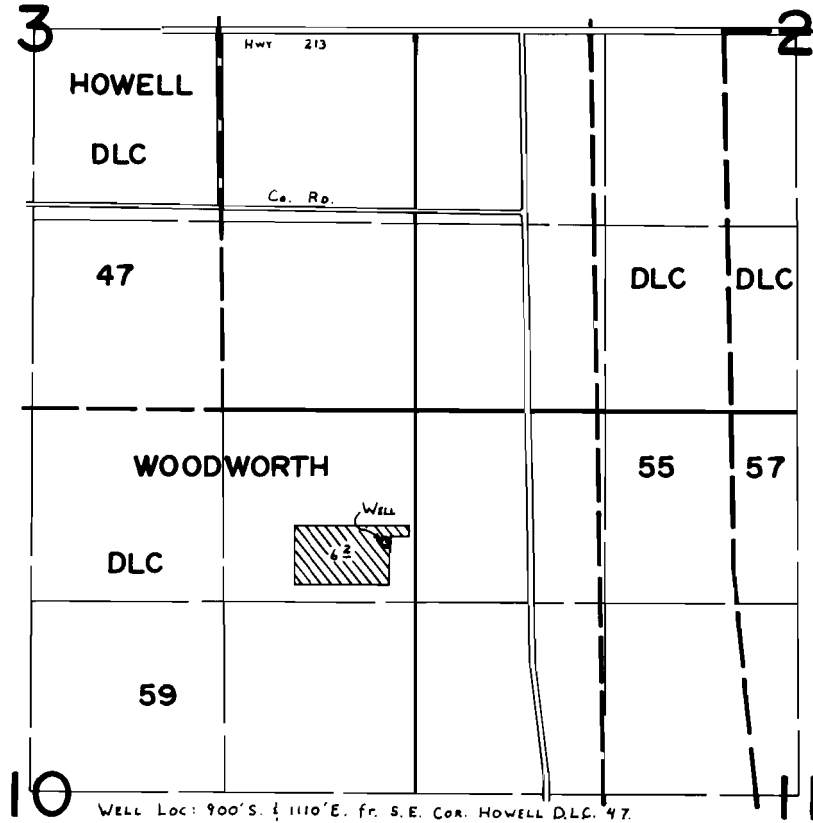

FINAL PROOF SURVEY UNDER

Application No. ~~G-6830~~ Permit No. ~~G-6325~~
IN NAME OF

PATRICK & NANCY SCHAECHER

Surveyed May 1 1980, by C. L. HUGHES