


T.5S. R.2W. W.M.

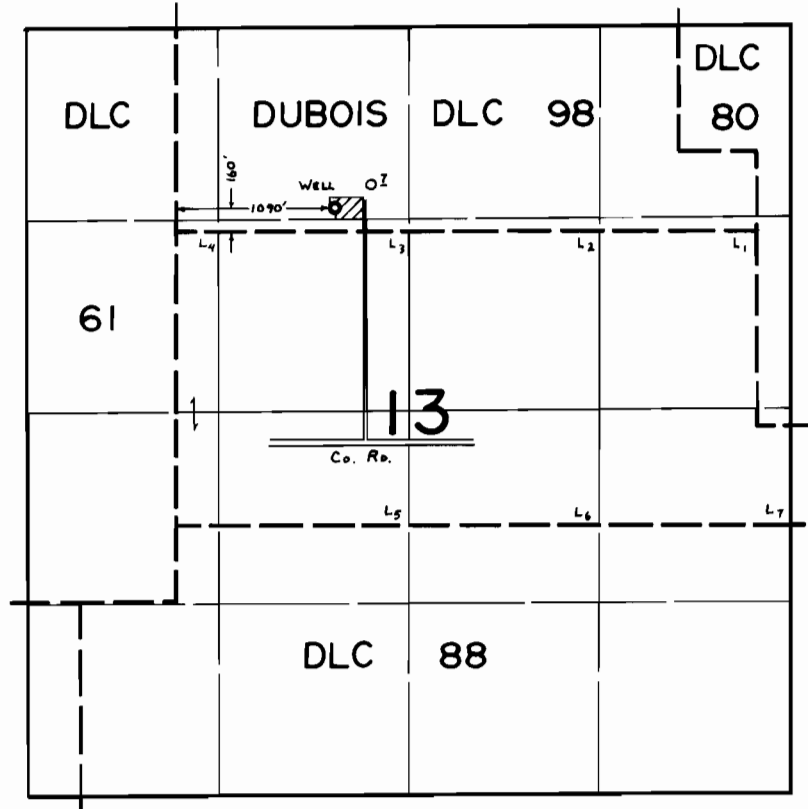

FINAL PROOF SURVEY
UNDER

Application No. G-7517 Permit No. G-6991
IN NAME OF

STEPHEN HOBSON

Surveyed June 30, 1980, by C. L. Hughes