


T7S R2W WM

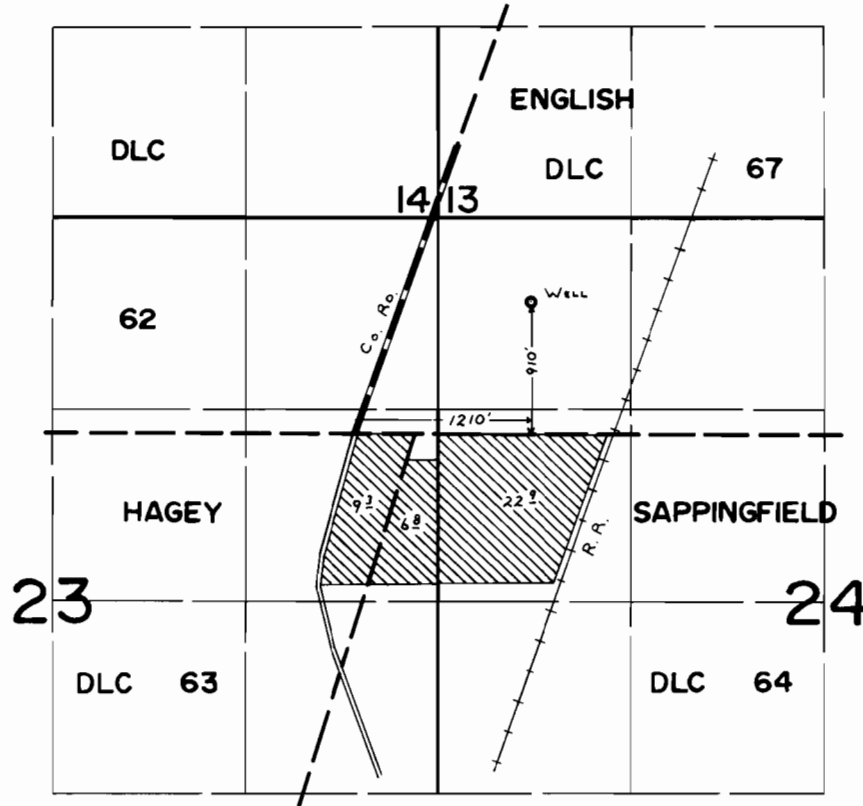

FINAL PROOF SURVEY UNDER

Application No. ~~G-8038~~ Permit No. G-7451.....
IN NAME OF

.....CECIL E. ROTH.....

Surveyed JUNE 26, 1980, by C. L. HUNTER.....