


T7S R2W WM

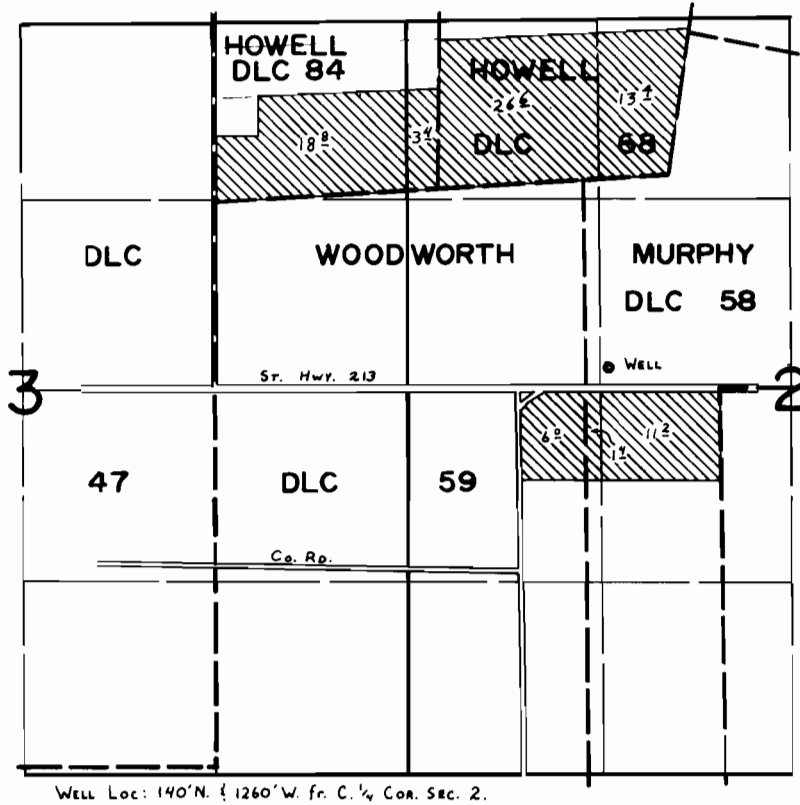

FINAL PROOF SURVEY UNDER

Application No. ~~G-8554~~ Permit No. ~~G-7867~~...
IN NAME OF

.....**EDWARD A. HARI**.....

Surveyed ~~...MAY...2...~~ 19~~80~~, by ~~...C. L. HARRIS...~~