


T. 4S., R. 1W., W.M.

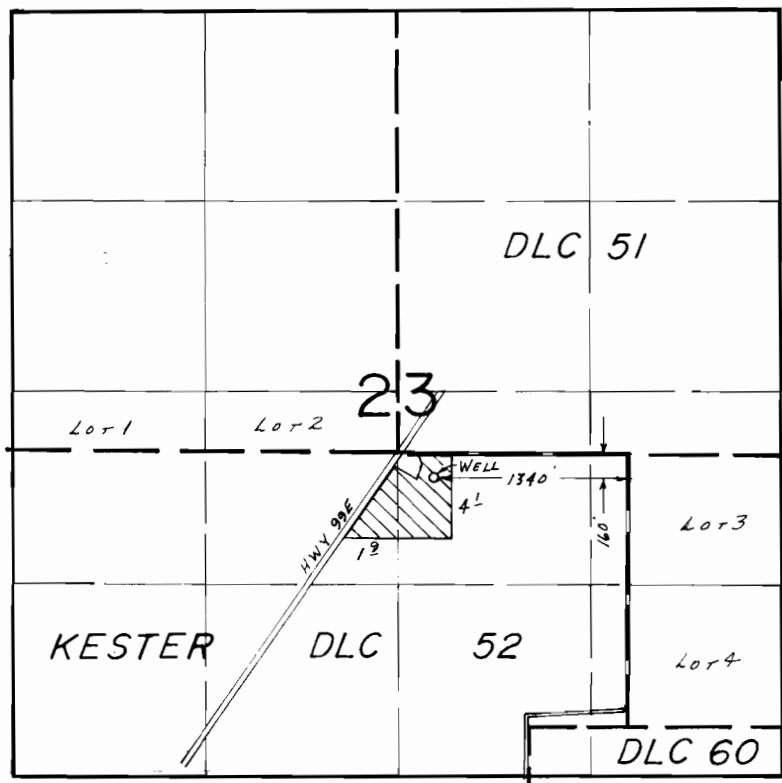

SCALE: 1" = 1320

FINAL PROOF SURVEY
UNDER

Application No. G:11336. Permit No. G:10468...
IN NAME OF

..... JULIA C. NELSON

Surveyed Aug. 23... 19.85, by B.W. BISHOP.....