


T. 1 S., R. 2 W., W. M.

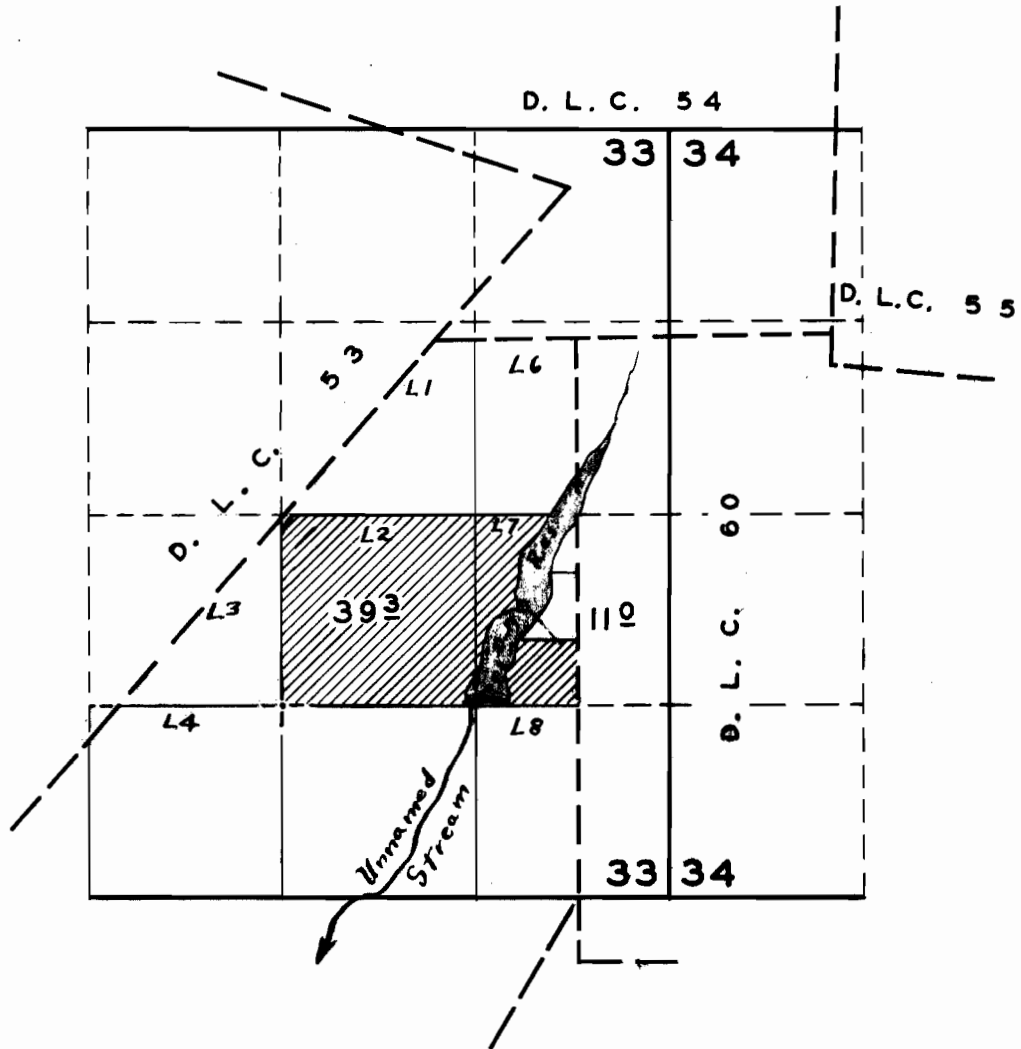

FINAL PROOF SURVEY

UNDER
R-23694 R-1030
Application No. 23695 Permit No. 19431
IN NAME OF

JACKSON BROTHERS, JOSEPH & CHARLES

Surveyed 4 - 26 1956, by M. B. I. S. H.