T.19S.,R.46E.,W.M.

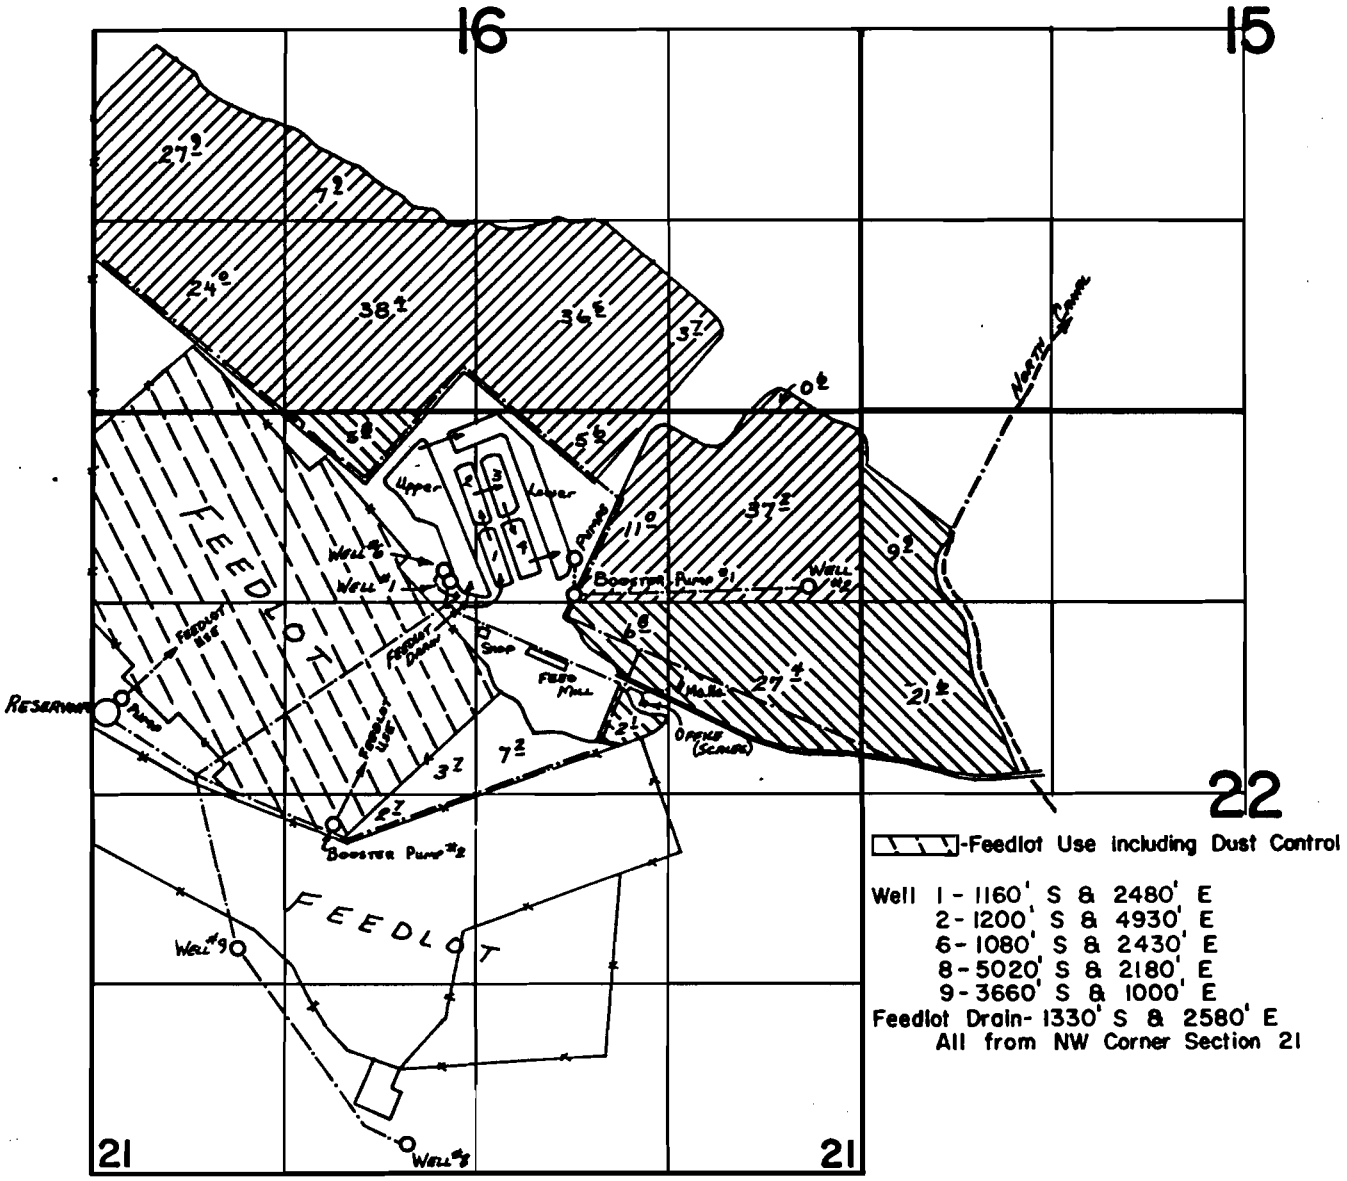

FINAL PROOF SURVEY

UNDER

R-52207	R-6092
52244	37546
G-6161	G-5269
56177	42127

Primary Irri.
Supp'l Irri.
Primary Irri.
Supp'l Irri.

Application No. G-7516 Permit No. G-7761

IN NAME OF

TRAVELERS INS. CO. AND
VICTORIO LAND & CATTLE CO.

Surveyed Aug. 22. 1983., by L. M. TOLL

ASCS Photo & Zoom