


T.19S.,R.46E.,W.M.

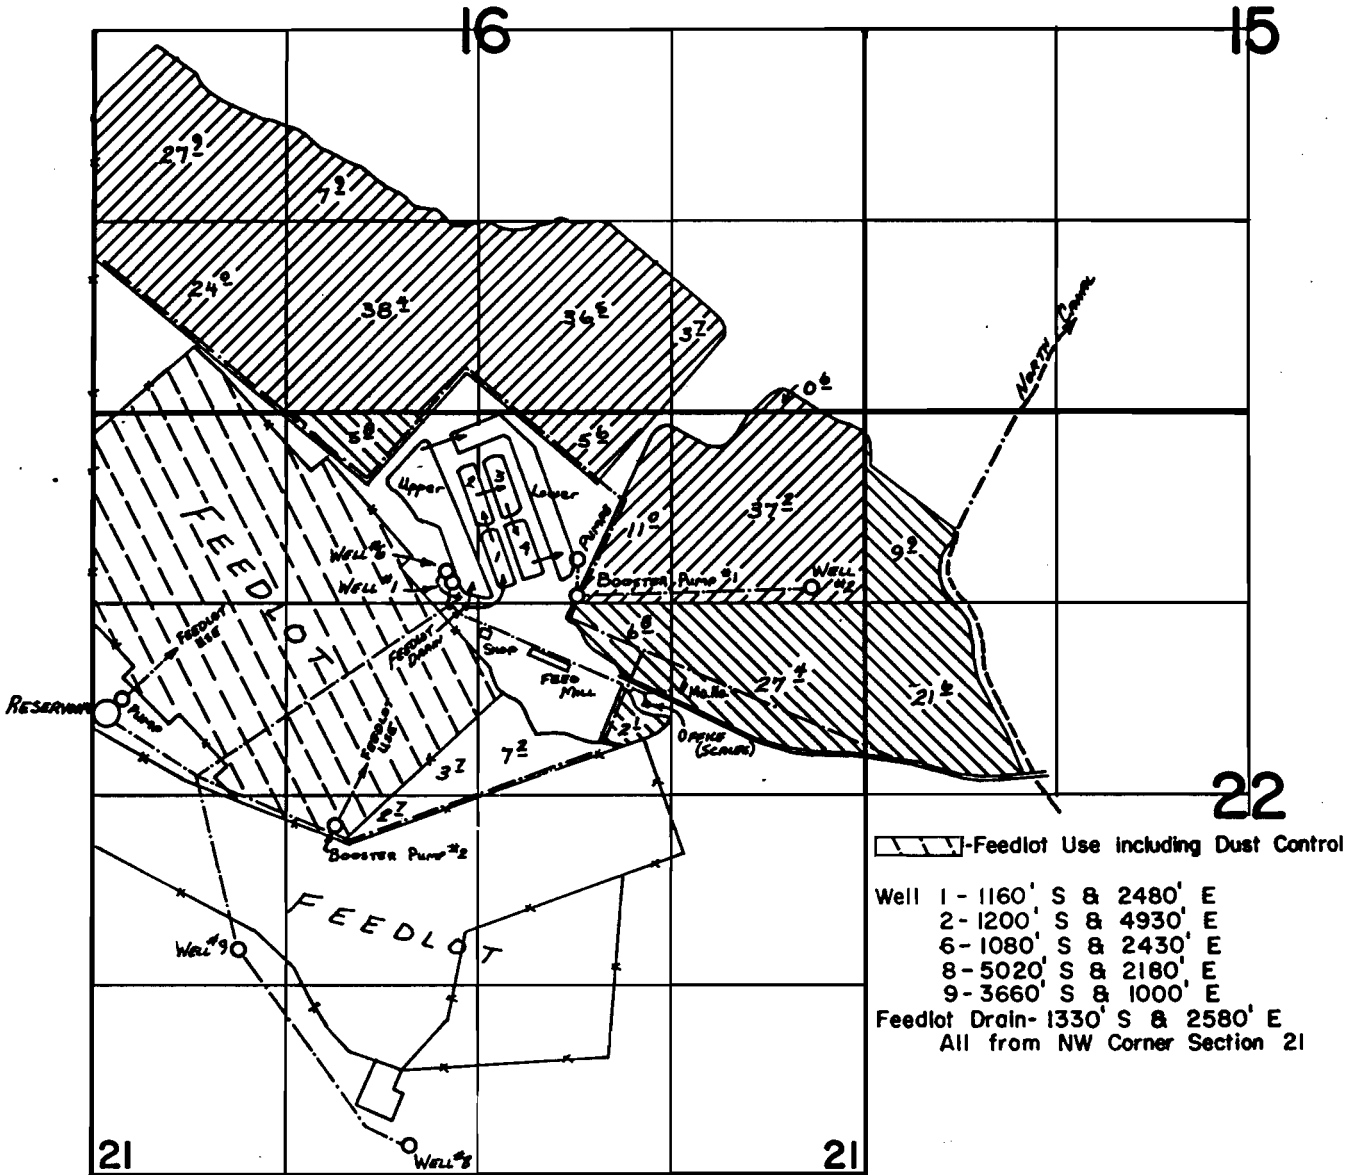

- Feedlot Use including Dust Control

- Well 1 - 1160' S & 2480' E
- 2 - 1200' S & 4930' E
- 6 - 1080' S & 2430' E
- 8 - 5020' S & 2180' E
- 9 - 3660' S & 1000' E
- Feedlot Drain - 1330' S & 2580' E
- All from NW Corner Section 21

FINAL PROOF SURVEY

UNDER

R-52207	R-6092
52244	37546
G-6161	G-5269
56177	42127

Application No. G-7516... Permit No. G-7761.....

	Primary Irrl.
	Suppl Irrl.
	Primry Irrl.
	Suppl Irrl.

IN NAME OF
**TRAVELERS INS. CO. AND
 VICTORIO...LAND &...CATTLE...CO..**

Surveyed Aug..22.. 1983., by ..L..M..TOLL.....