T.19S.,R.46E.,W.M.

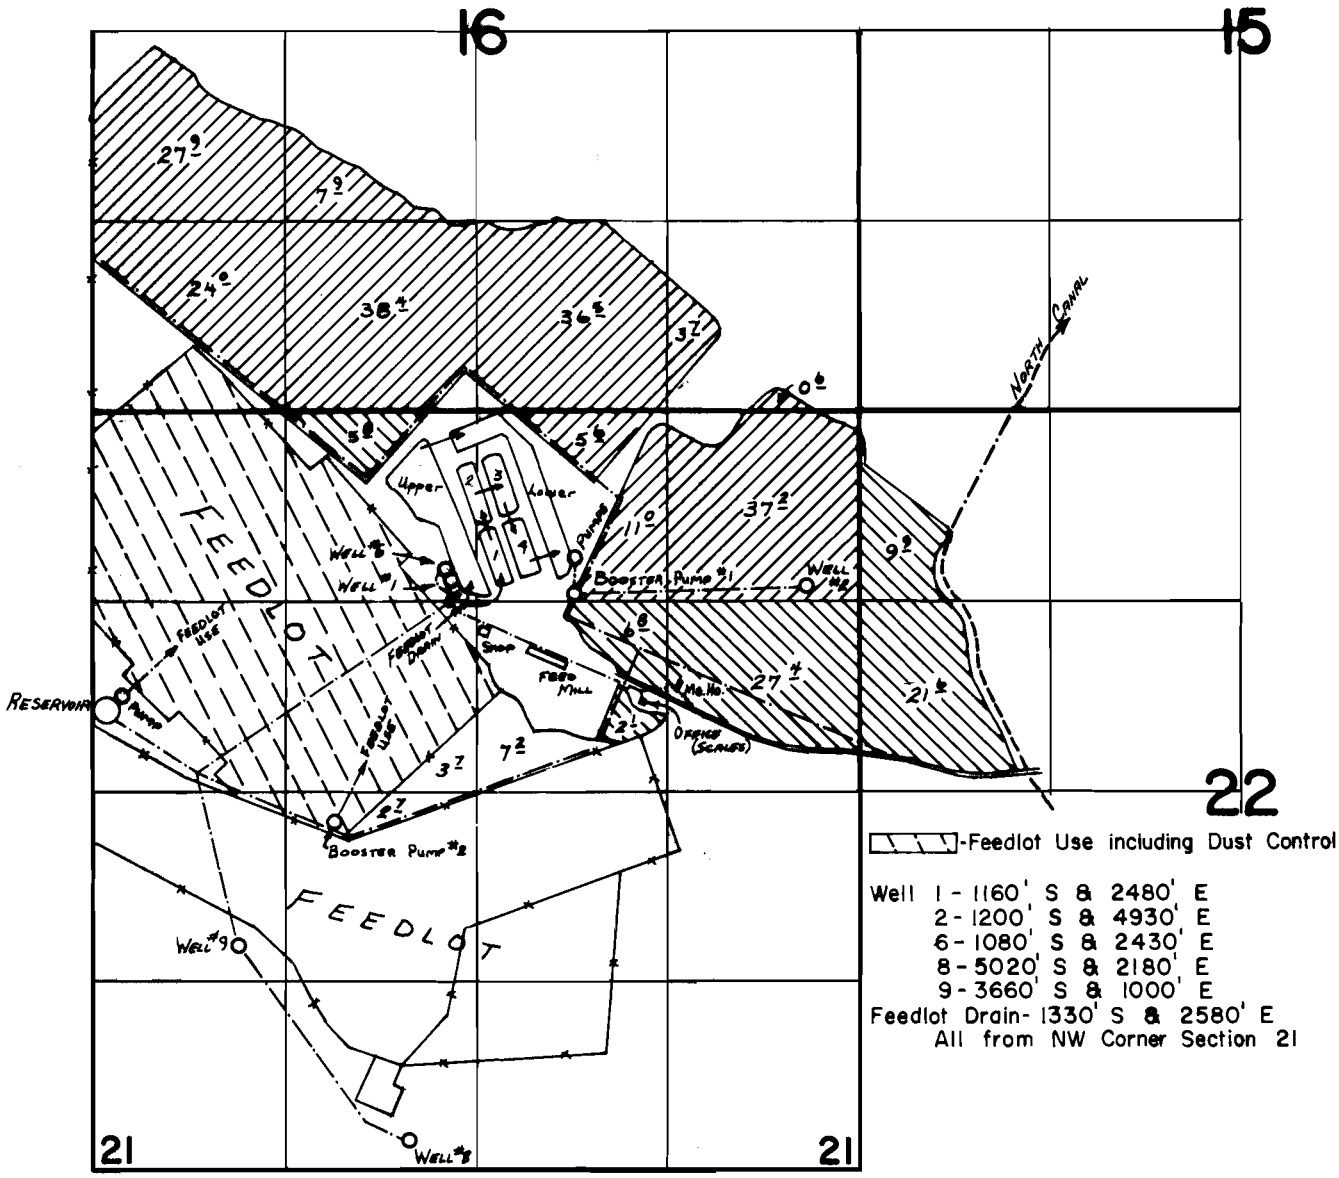

-Feedlot Use including Dust Control

Well 1 - 1160' S & 2480' E
2 - 1200' S & 4930' E
6 - 1080' S & 2430' E
8 - 5020' S & 2180' E
9 - 3660' S & 1000' E
Feedlot Drain- 1330' S & 2580' E
All from NW Corner Section 21

FINAL PROOF SURVEY

UNDER

R-52207	R-6092		Primary Irri.
52244	37546		Supp'l Irri.
G-6161	G-5269		Primary Irri.
56177	42127		Supp'l Irri.

Application No. G-7516 Permit No. G-7761

IN NAME OF

TRAVELERS INS. CO. AND
VICTORIO LAND & CATTLE CO.

Surveyed Aug. 22. 19.83., by L. M. TOLL

ASCS Photos of Zoom