


T.19S.,R.46E.,W.M.

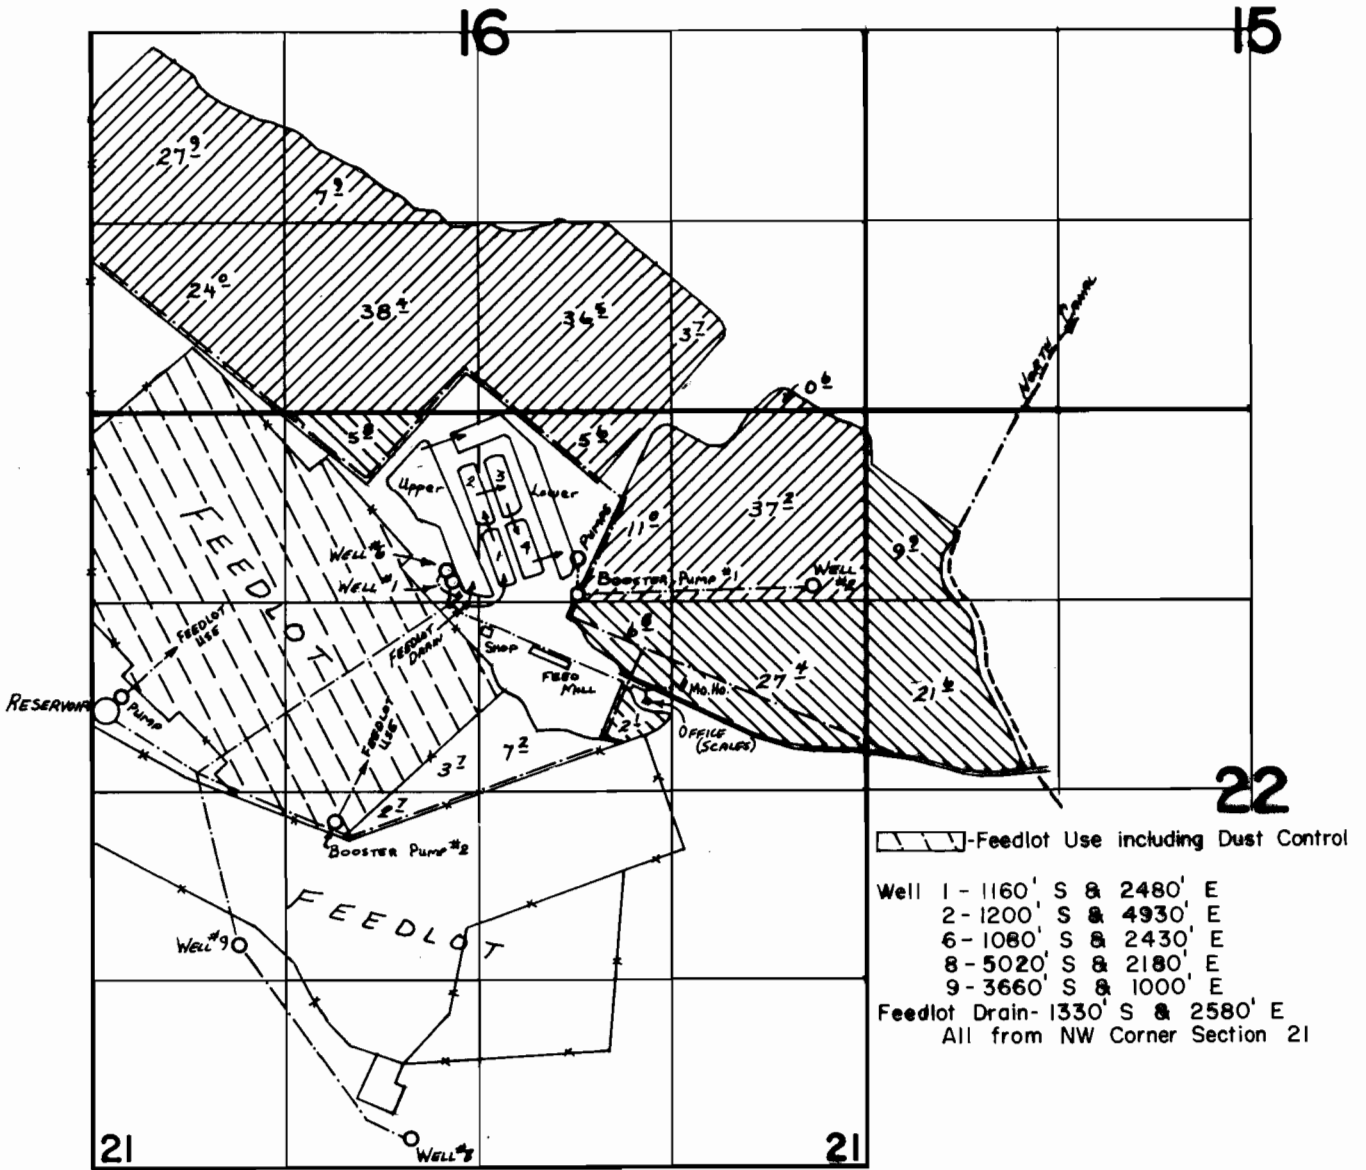

- Feedlot Use including Dust Control

- Well 1 - 1160' S & 2480' E
- 2 - 1200' S & 4930' E
- 6 - 1080' S & 2430' E
- 8 - 5020' S & 2180' E
- 9 - 3660' S & 1000' E
- Feedlot Drain - 1330' S & 2580' E
- All from NW Corner Section 21

FINAL PROOF SURVEY

UNDER

R-52207
 52244
 G-6161
 56177
 R-6092
 37546
 G-5269
 42127

Application No. ..G.:7.516... Permit No. ..G.:7.7.6].....

Primary Irri.
 Suppl Irri.
 Primpry Irri.
 Suppl Irri.

IN NAME OF
**TRAVELERS INS. CO. AND
 VICTORIO LAND & CATTLE CO.**

Surveyed Aug..22.. 19.83., by ..L..M..TOLL.....