


T.6N.R.10W.W.M.

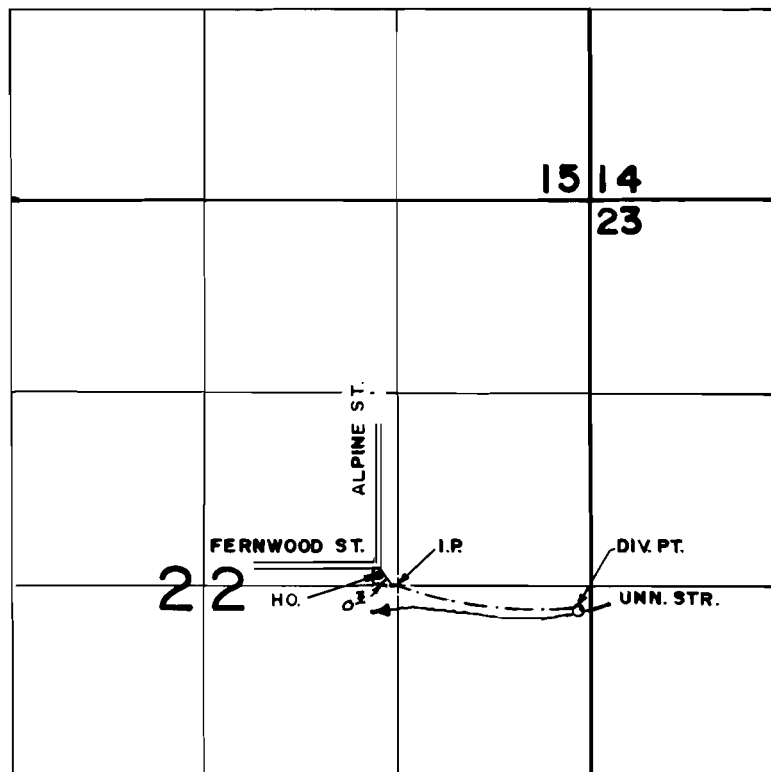

DIV. PT. LOC. 180' S. & 1240' E. FROM NW. COR. NE. 1/4 SE. 1/4 SEC. 22

FINAL PROOF SURVEY
UNDER

Application No. 55373 Permit No. 41501
IN NAME OF

E. ROY & MARY C. COLE

Surveyed FEB 20 1980, by R.G. MUCKEN