


T.26S., R.34E., W.M.

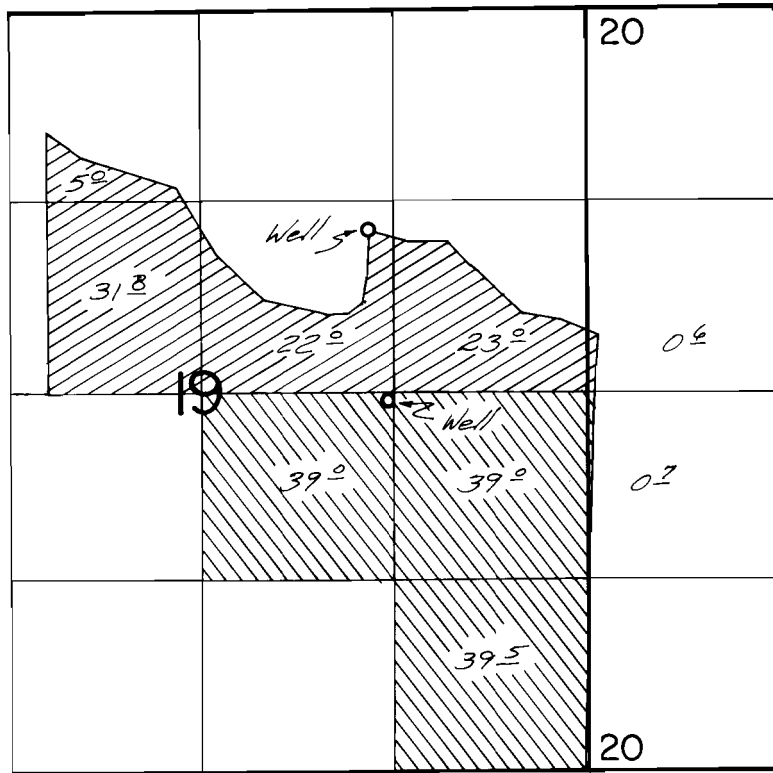

Wells Loc: 70' S & 40' W; 1230' N. & 170' W., both from the NE corner NW 1/4 SE 1/4

FINAL PROOF SURVEY UNDER

Application No. G-6056 G-8973 Permit No. G-5183 G-8372



IN NAME OF

Nevin Thompson

Surveyed Aug 26, 1979, by RG MUCKEN