


T.23S. R.31E., W.M.

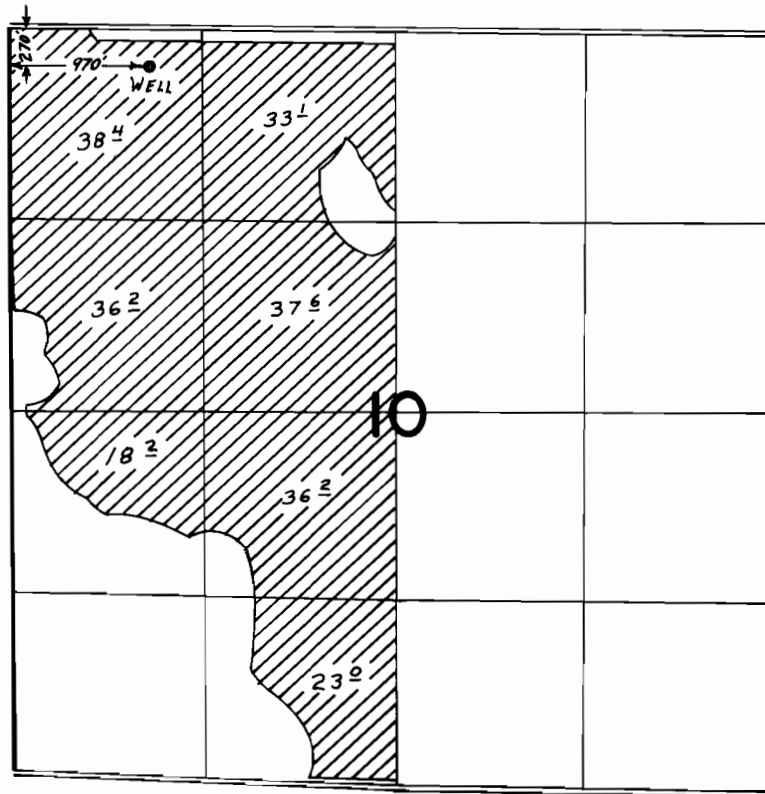

FINAL PROOF SURVEY
UNDER

Application No. G-6362. Permit No. G-5959.....
IN NAME OF

.....SAM & ARLICE GUNDERSON.....

Surveyed JULY 28, 1979, by R. G. MUCKEN.....