


G-6542
55573

T24S R31E WM Sec. 33
Scale: 4" = 1 mile

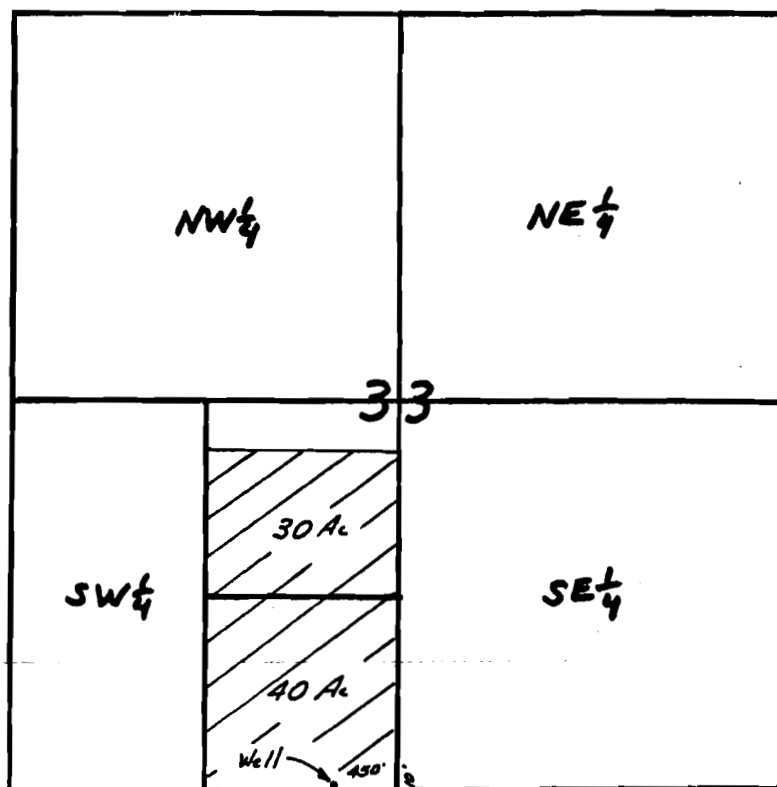

Application No. G-7063

Permit No. G 6542