


G-6961
55574

T.25S. R.31E. W.M.

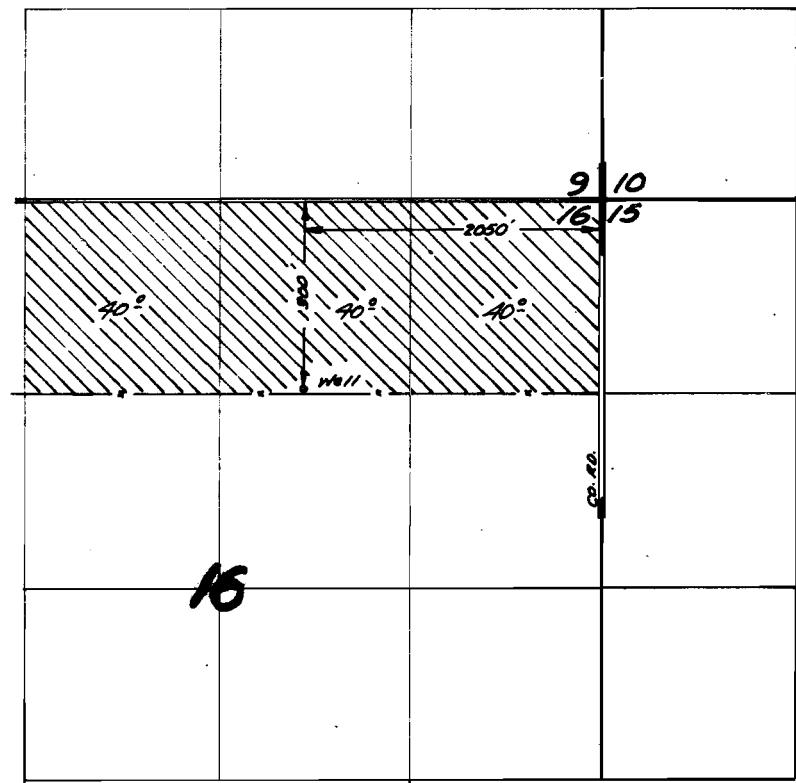

Application No. 5-17477
Permit No. G 6961