


T.24S.,R.31E.,W.M.

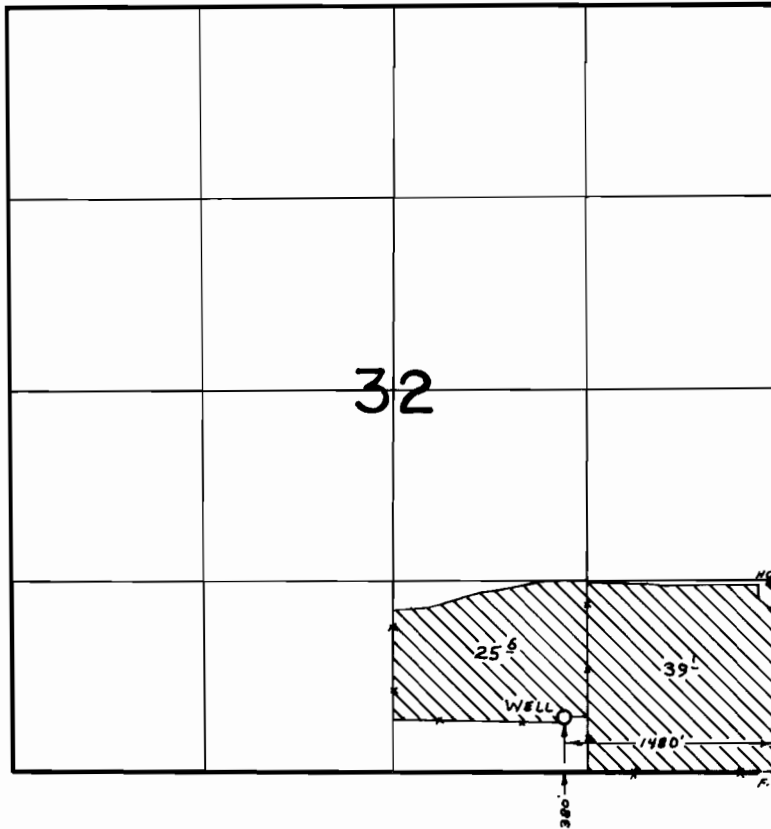

FINAL PROOF SURVEY
UNDER

Application No. G-8645 Permit No. G-7992
IN NAME OF

CURLEY AND BLANCH ANGELL

Surveyed OCT. 6. 1981, by L. TOLL