


T.25S.,R.34E.,W.M.

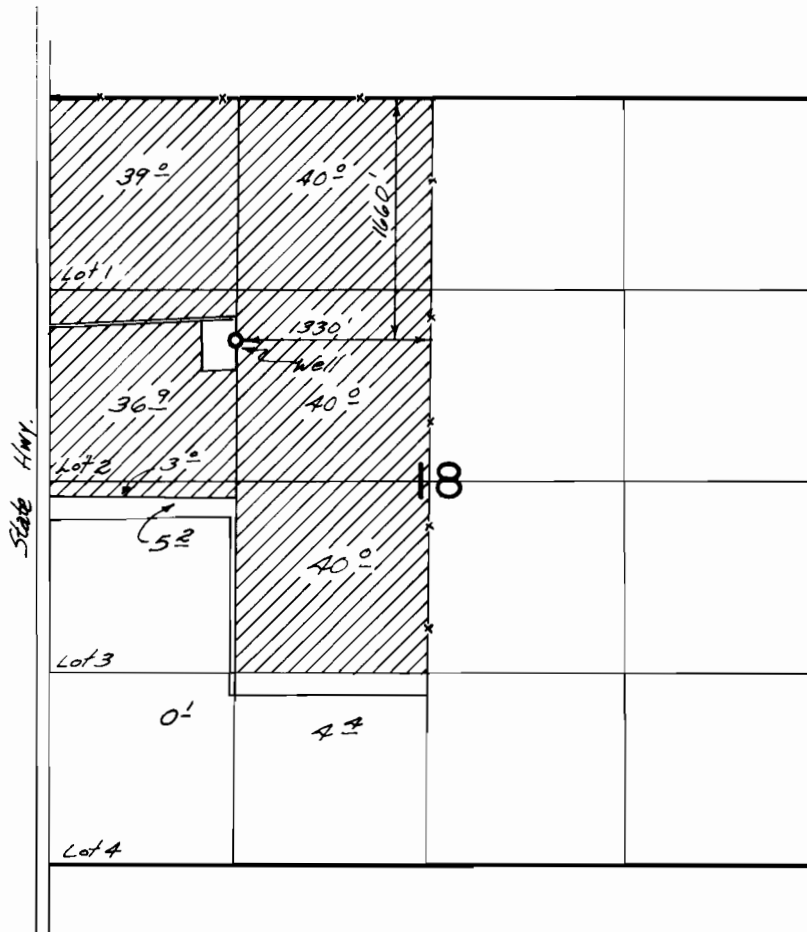

FINAL PROOF SURVEY
UNDER

Application No. G-8802 Permit No. G-8243
IN NAME OF

William & Melinda Schaffer

Surveyed AUG 27, 1979, by R.G. MUCKEN