


T23S. R31E. WM.

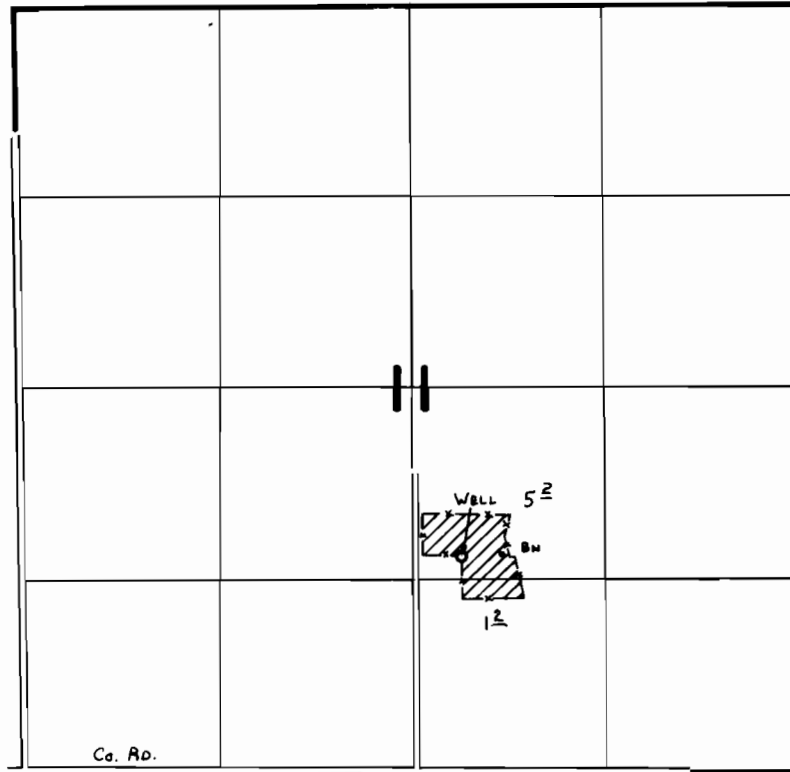

WELL Loc: 1480' N. & 340' E. fr. S $\frac{1}{4}$ Cor. Sec. 11.

FINAL PROOF SURVEY UNDER

Application No. G-10259 Permit No. G-9406
IN NAME OF

CARL L. & LOTTIE M. WILKE

Surveyed AUG. 25 1978, by C. L. HUGHES
SEPT. 7 1981, by L.M. TOLL