

RECEIVED


JUN 5 1978

WATER RESOURCES DEPT.  
SALEM, OREGON

6-8110

T. 1 N., R. 9 E., W. M.

Scale 1" = 200 ft.

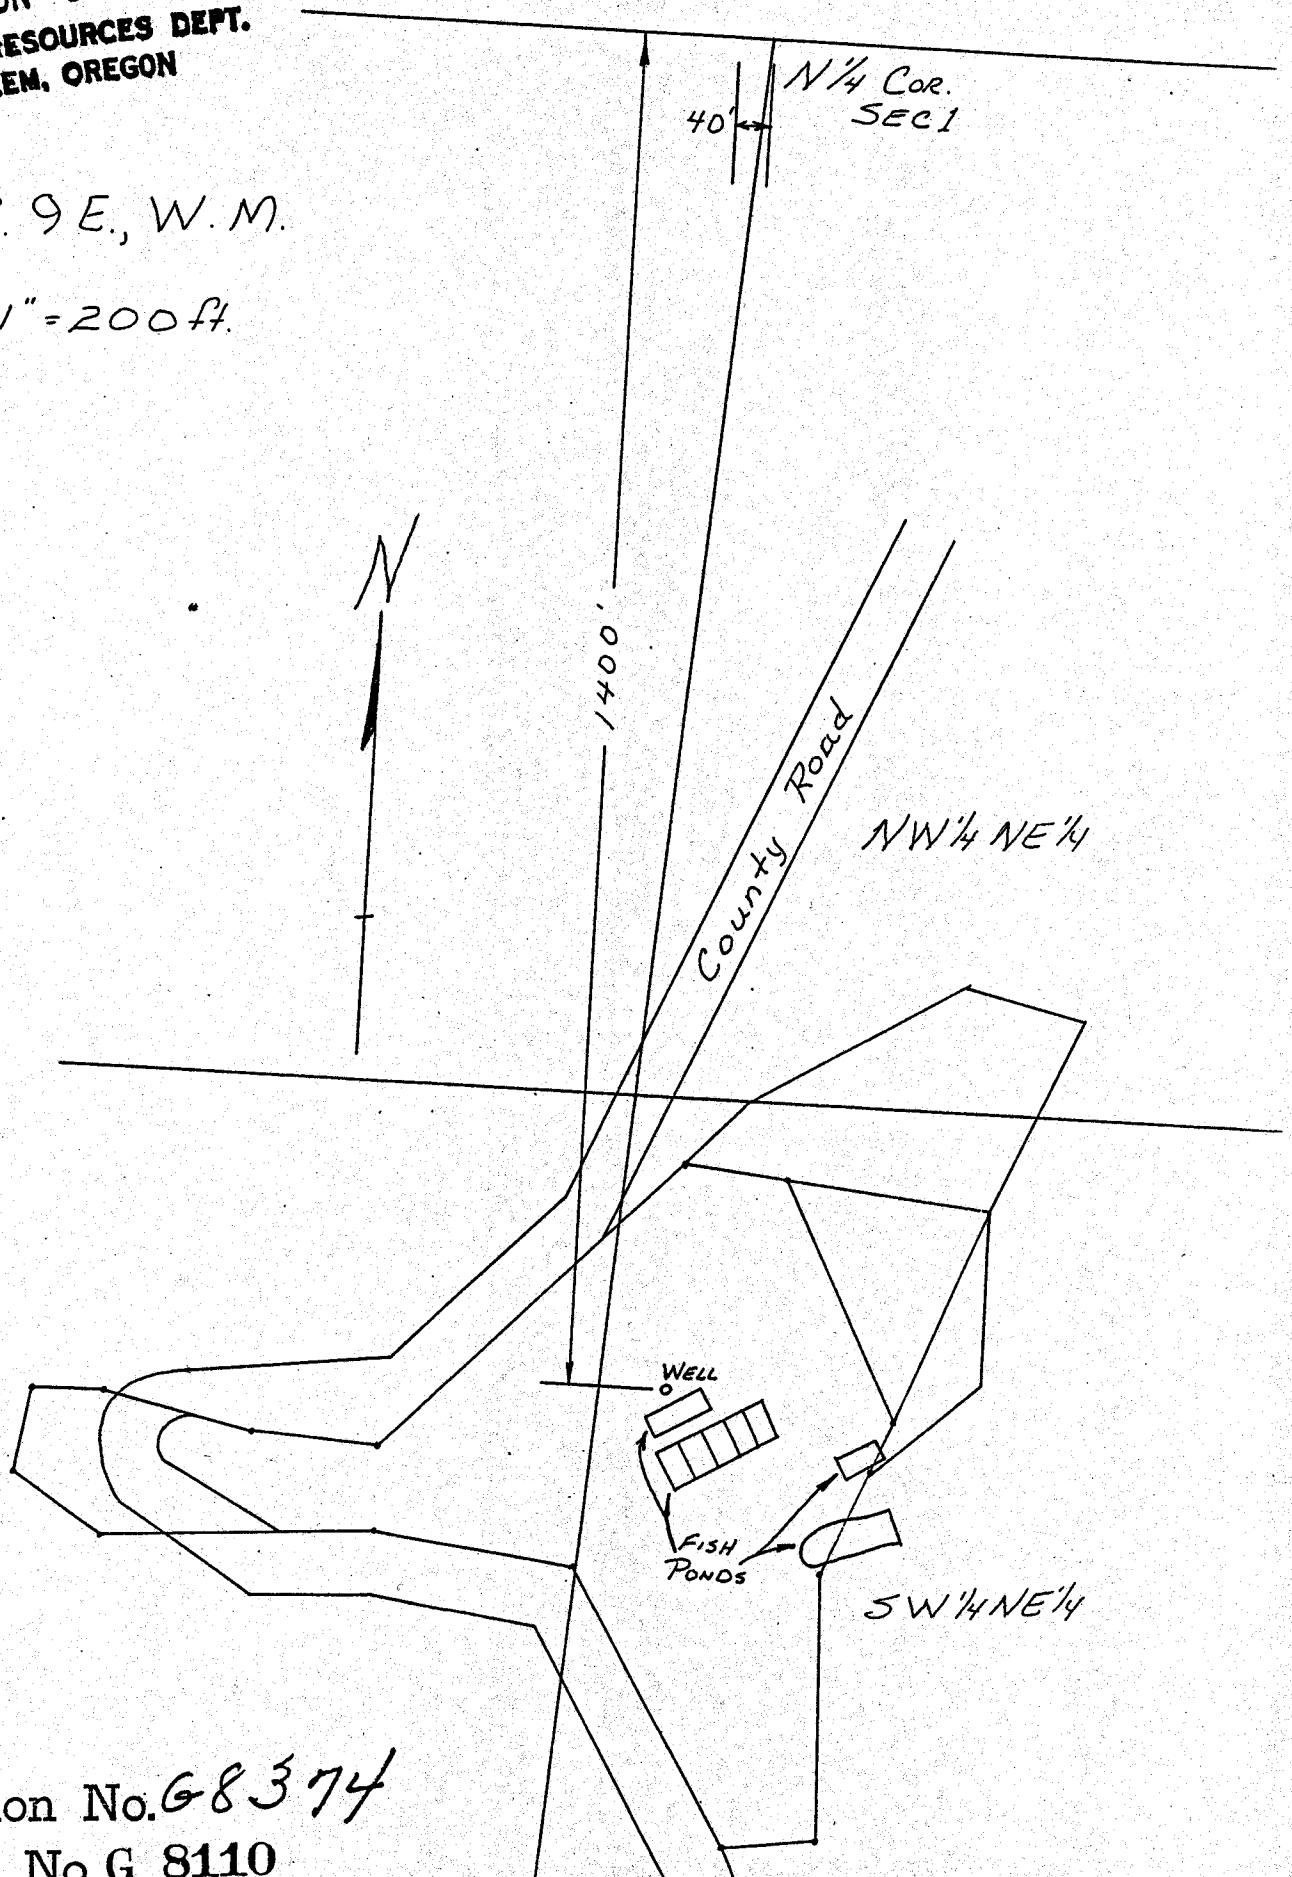

Application No. 68374

Permit No. G 8110