


T.9S. R.14E. W.M.

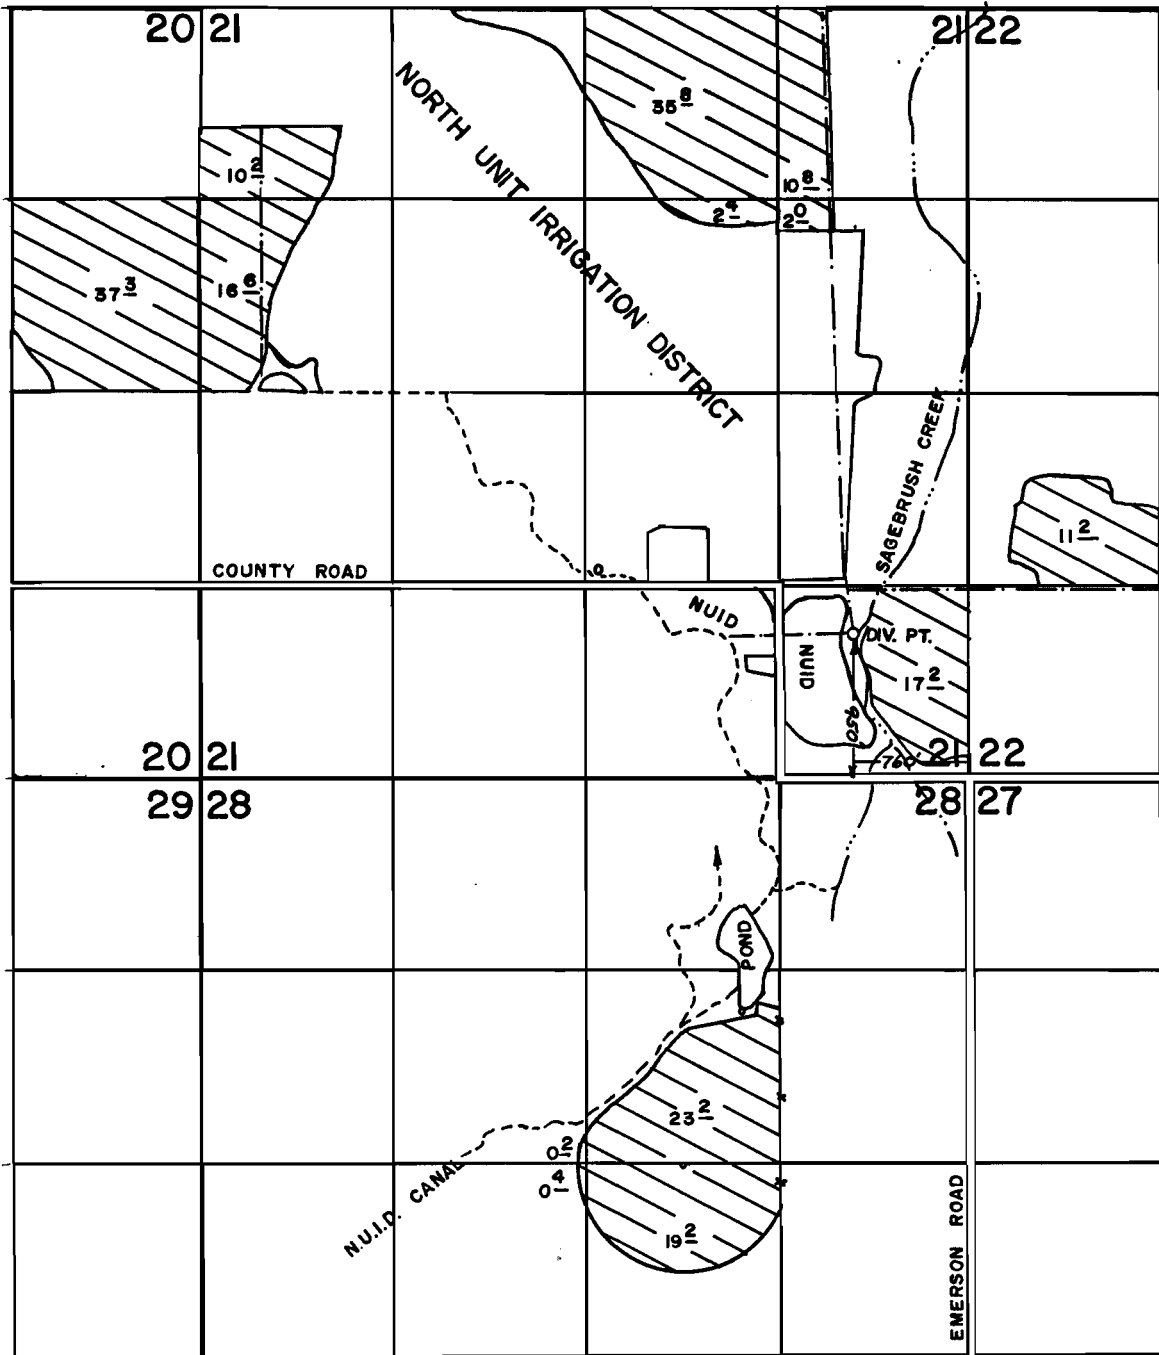

FINAL PROOF SURVEY UNDER

Application No. 49366.. Permit No. 36704.....
IN NAME OF

MELVIN & WILLIAM DuRETTE CERT # 55583

Surveyed OCT...6... 1980., by L.H...NUNN.....