


T.21S.,R.46E.,W.M.

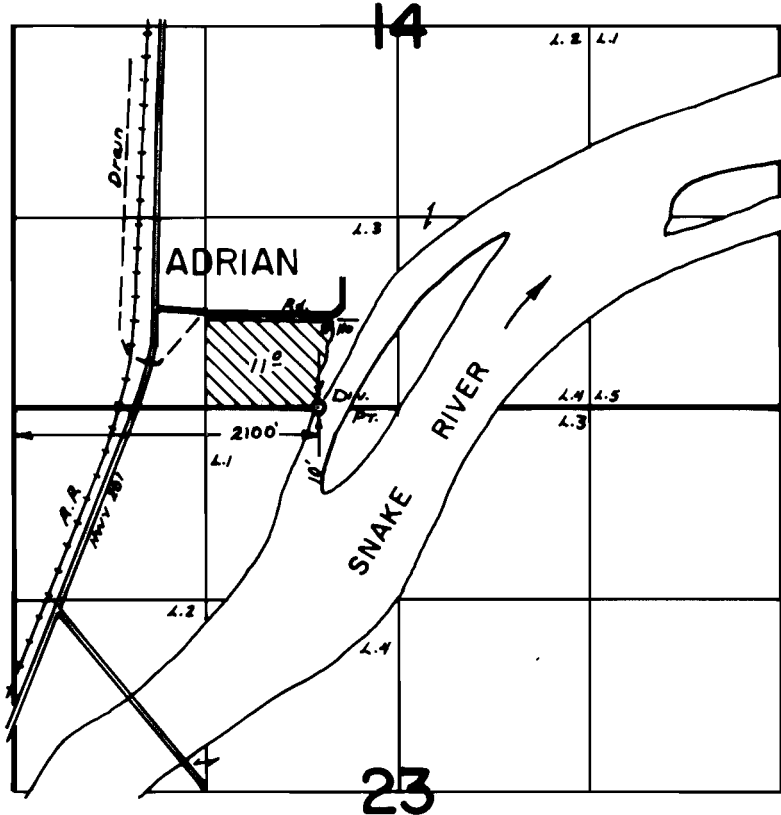

FINAL PROOF SURVEY UNDER

Application No. .54266.. Permit No. .40719.....
IN NAME OF

.....**OLIVER FREEL**.....

Surveyed .Aug. 20. 1983., by .L.M.TOLL.....