


T.17S.,R.47E.,W.M.

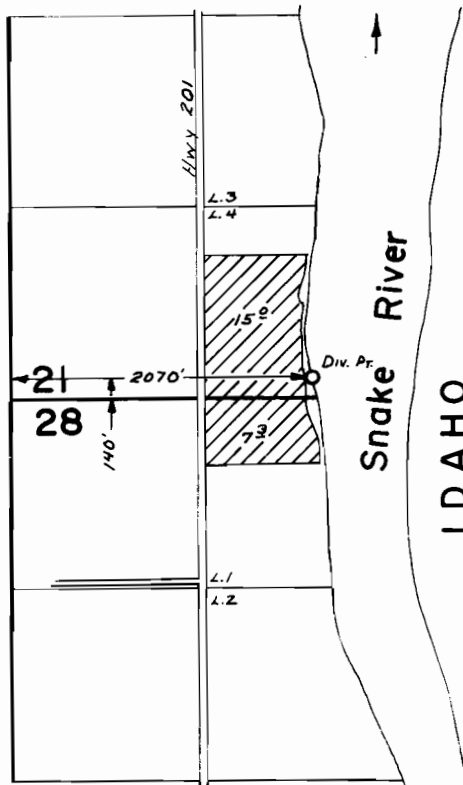

FINAL PROOF SURVEY
UNDER

Application No. 55420. Permit No. 41528
IN NAME OF

ROBERT CRUICKSHANK

Surveyed Aug. 31, 1981, by B. BISHOP