


T.17S.,R.47E.,W.M.

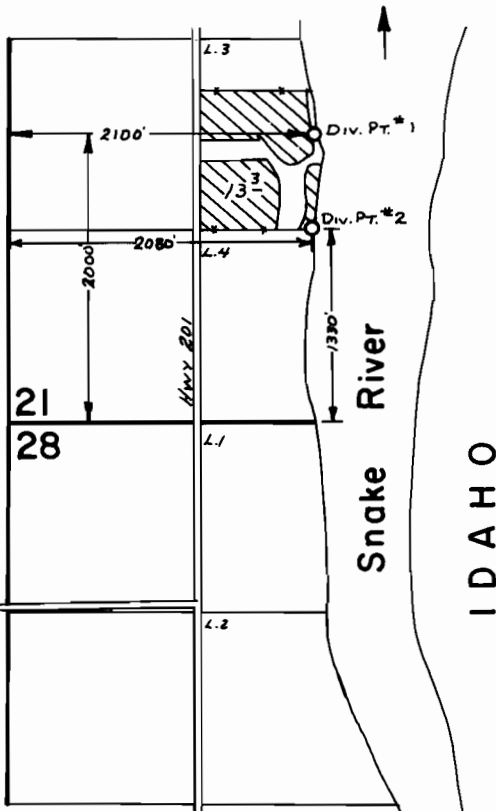

FINAL PROOF SURVEY

UNDER

Application No. 60109 Permit No. 44975
IN NAME OF

.....ELLSWORTH J. WRIGHT

Surveyed Aug...18.... 19.83., by ..L...M...TOLL.....