



T.28S.,R.46E.,W.M.

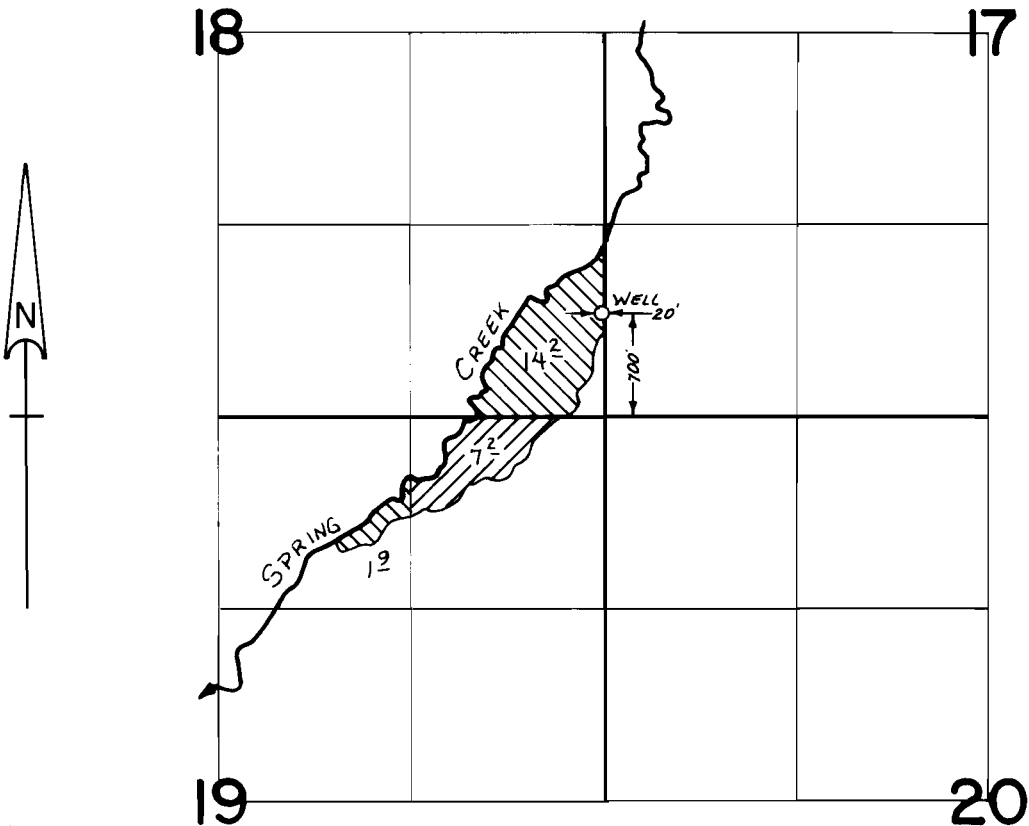

SCALE: 1" = 1320'

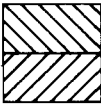

Primary

Supplemental

FINAL PROOF SURVEY
UNDER

Application No. G-3737 Permit No. G-3534
IN NAME OF

STODDART RANCHES

Surveyed Oct. 17, 1985, by L. M. TOLL