



T.27S.,R.38E.,W.M.

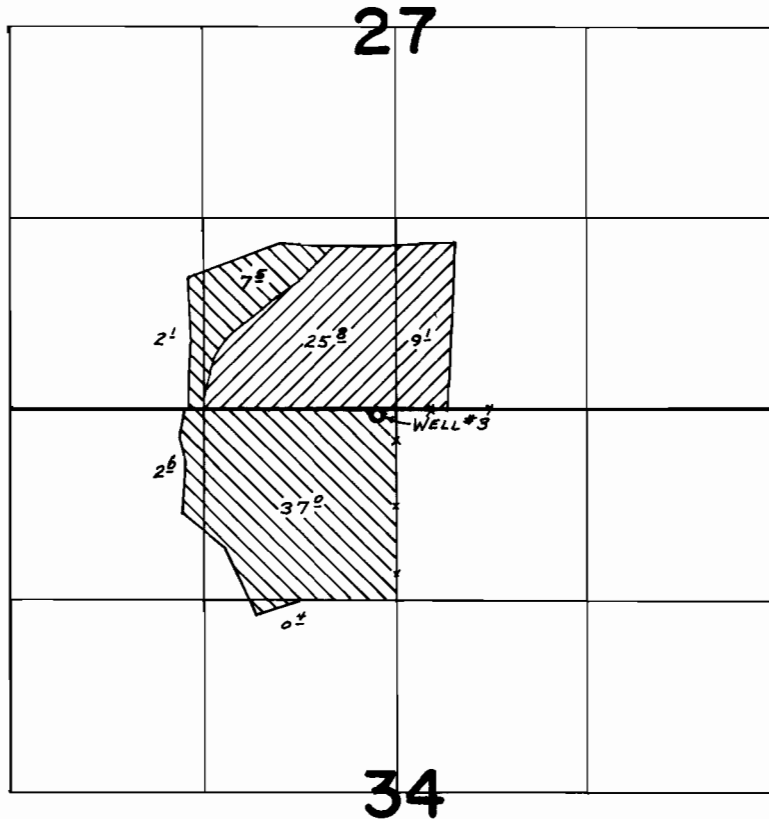

WELL LOCATION: 40 ft. S and 130 ft. W from the N¹/₄ Cor Sec. 34

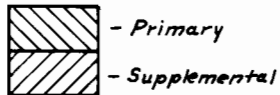

FINAL PROOF SURVEY UNDER

Application No. G-4094 Permit No. G-3845....
IN NAME OF

.....THOMAS T. DOWELL.....

Surveyed Oct..... 1981, by L.T. QLL.....