


T.27&28S.,R.38E.,W.M.

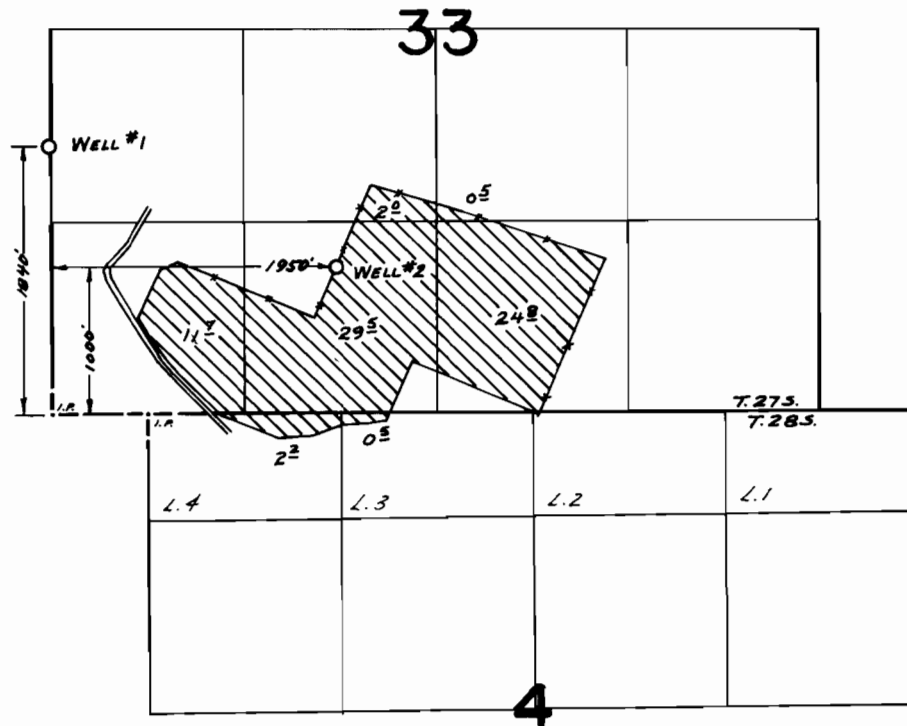

FINAL PROOF SURVEY
UNDER

Application No. G-4095 Permit No. G-3846....
IN NAME OF

.....THOMAS T. DOWELL.....

Surveyed Oct. 1981, by L. TOLL.....