


T.17S.,R.44E.,W.M.

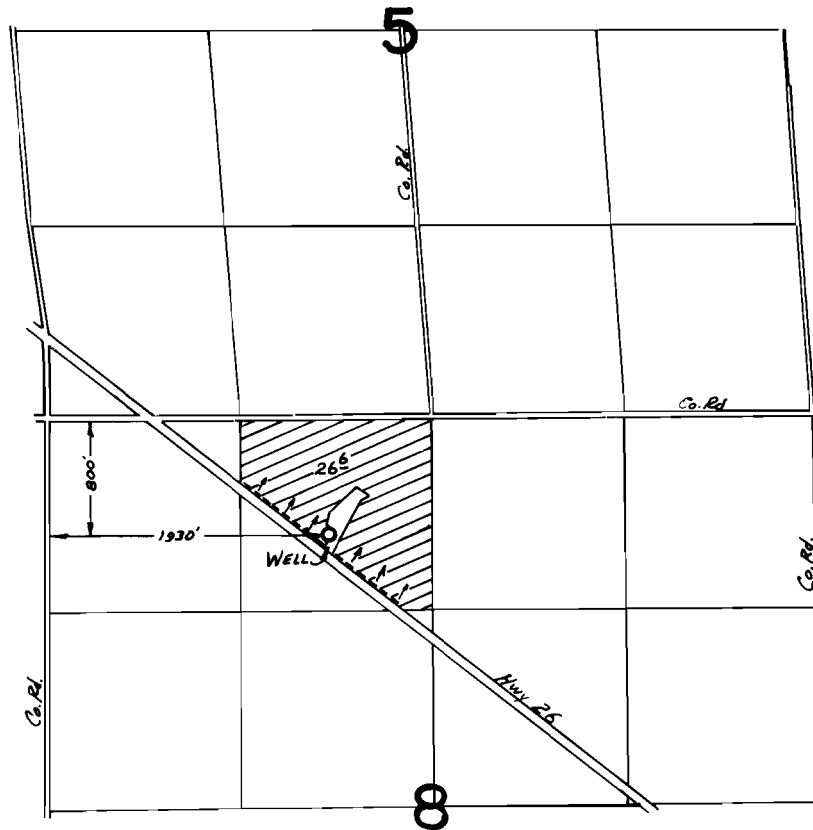

**FINAL PROOF SURVEY**  
UNDER

Application No. G:8900. Permit No. G:8307.....  
IN NAME OF

**RALPH M. AND GLADYS M. PERSHALL**

Surveyed Sept. .... 1981., by ...L...TOLL.....