


G 5248
55596

T. 5N., R. 27E., W.M.

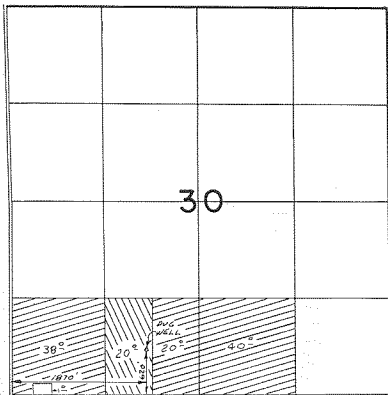

PRIM.



SUPP'L.

FINAL PROOF SURVEY
UNDER

Application No. **G-6201** Permit No. **G-5248**
IN NAME OF

WAYNE H. SCHNELL

Surveyed *Feb 2* 19*81*, by *Kenneth L. Schnell*