


G-6420
53599

T. 6N. R. 35E. W.M.

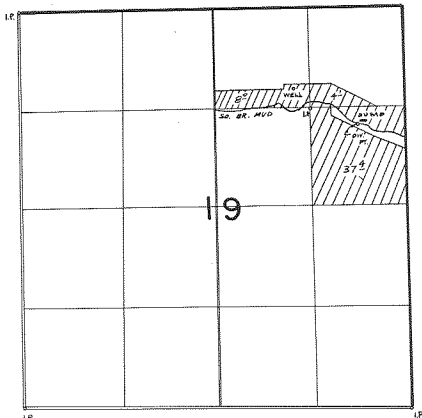

WELL LOC. 1100'S & 1100'E FROM N1/4 COR SEC 19

FINAL PROOF SURVEY
UNDER

Application No. G-6889. Permit No. G-6420.
IN NAME OF

LORENCE C. PFAFFLE

Surveyed 7-18 1978, by R. BARWIN