


# T.3&4N.R.29E.W.M.

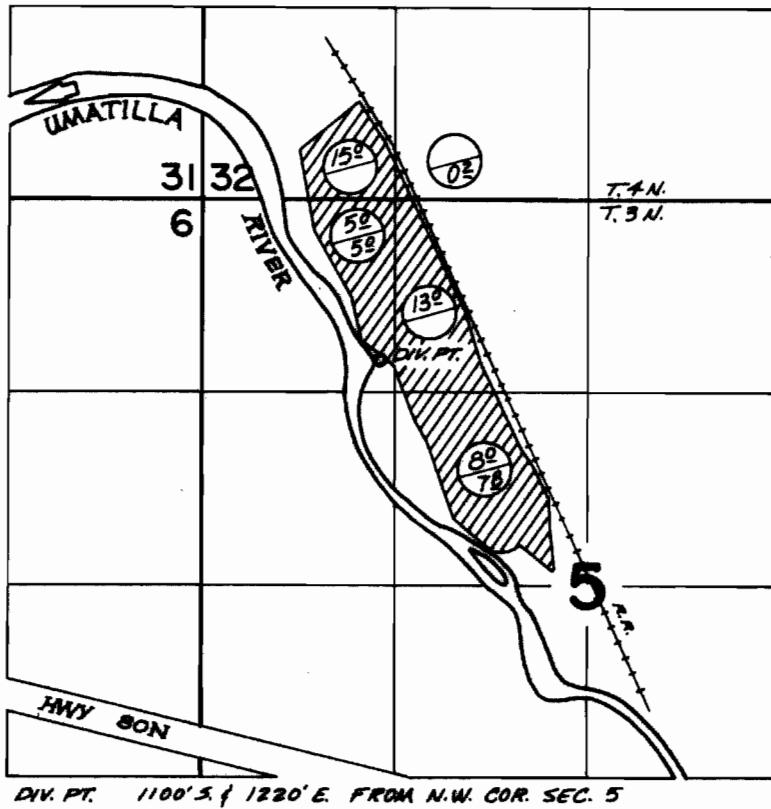

## FINAL PROOF SURVEY UNDER

 CERT. 2583  
PERMIT 36410

Application No. 49027 Permit No. 36410  
IN NAME OF

LELAND E. HASTINGS

Surveyed April 4, 1975, by R.G. Mucken