

C. 39-22

T. 5N, R. 27E, W.M.

COLUMBIA RIVER

DIV. PT.

16 15

UNION PAC RAILROAD

COLUMBIA RIVER HWY

WEST. RES. CANAL



20

21

29

28

33

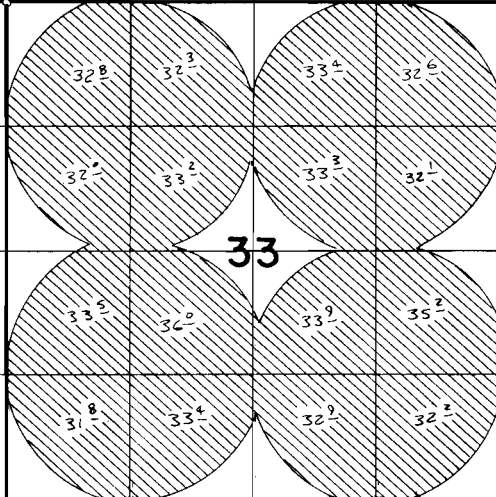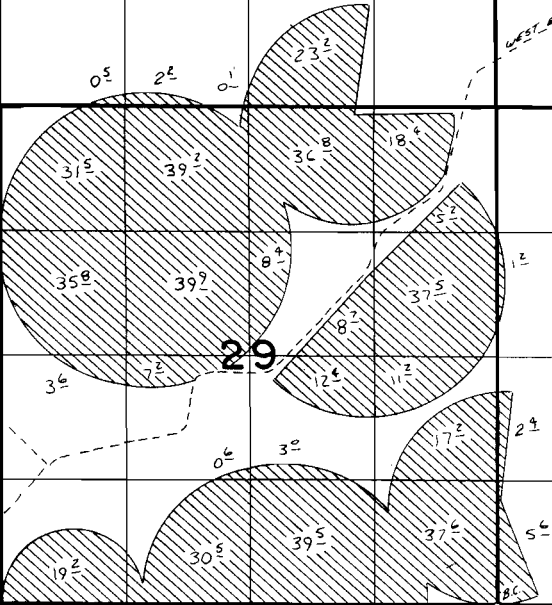

FINAL PROOF SURVEY UNDER

APPL. 52764 PER. 37775 IN NAME OF

CONNECTICUT GENERAL LIFE INS. CO.

Surveyed JULY 11 1979, by V. Church