


T.6N.R.36E.W.M.

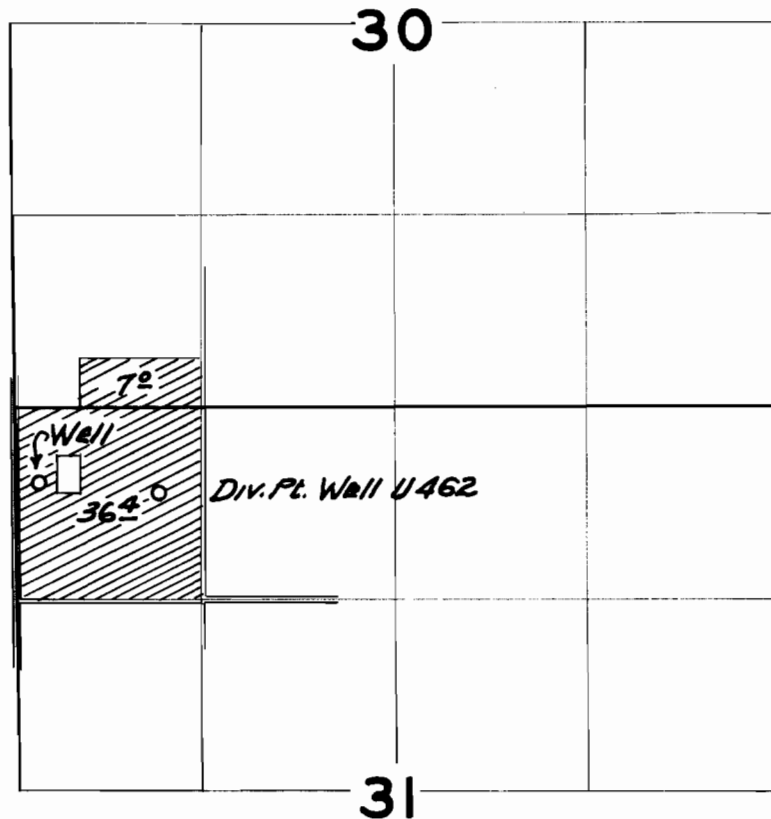

FINAL PROOF SURVEY

UNDER

Application No. 1-162 Permit No. 0-117

IN NAME OF

G. P. Nelson

Surveyed May 10, 1954, by H. I. Coffman