


# T.2N.R.33E.W.M.

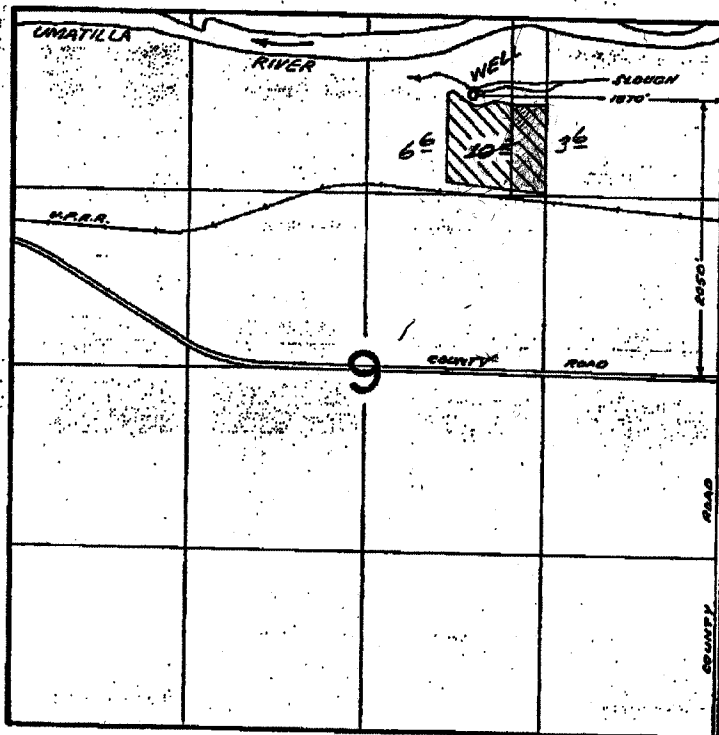

*36 Ac To be canceled*

## FINAL PROOF SURVEY UNDER

Application No. G-9388 Permit No. G-9095  
IN NAME OF

MR. AND MRS. IKE FERNANDEZ

Surveyed Apr 14 1973, by D.M. NORBY