


G 5698

55615

T. 2N., R. 33E., W. M.

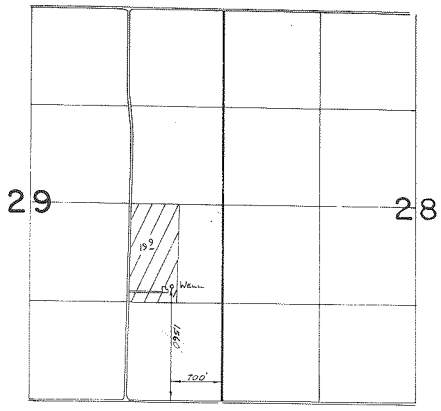

SCALE: 1" = 1320'

FINAL PROOF SURVEY  
UNDER

Application No. G. 6899 Permit No. G. 5698  
 IN NAME OF  
ROBERT E. THORNE  
 Surveyed 3-2 1972, by V. L. Church