


G-7070  
55617

T. 2N. R. 33E. W.M.

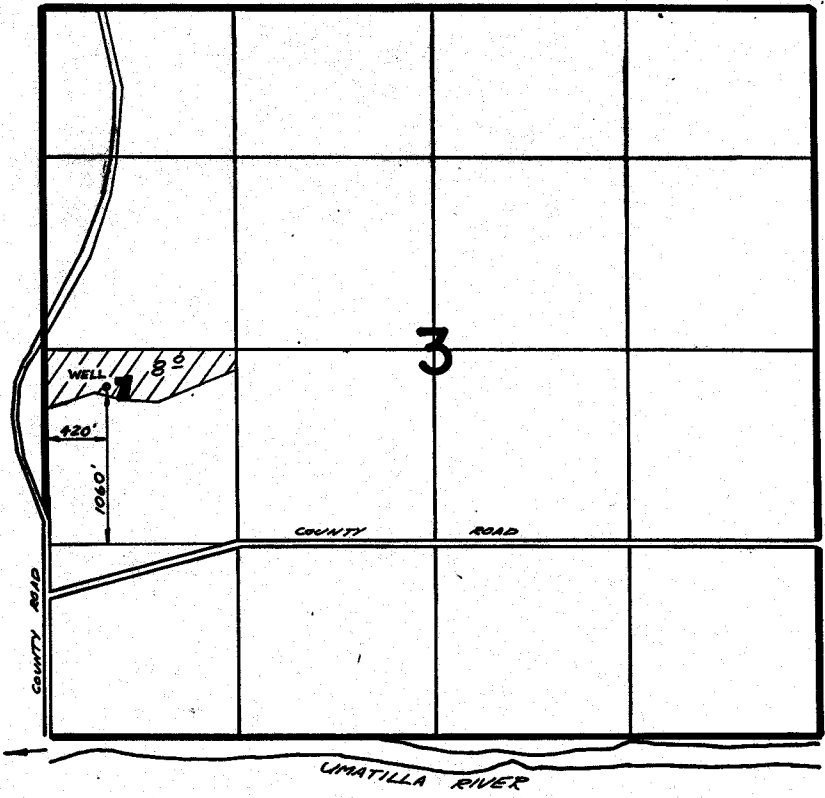

**FINAL PROOF SURVEY**  
UNDER

Application No. G-7633 Permit No. G-7070  
IN NAME OF  
**CLIFFORD C. PICARD**

Surveyed 3-2 1979, by V. CHURCH