



G 7392  
SSL18

# T. 6N., R. 35E., W.M.

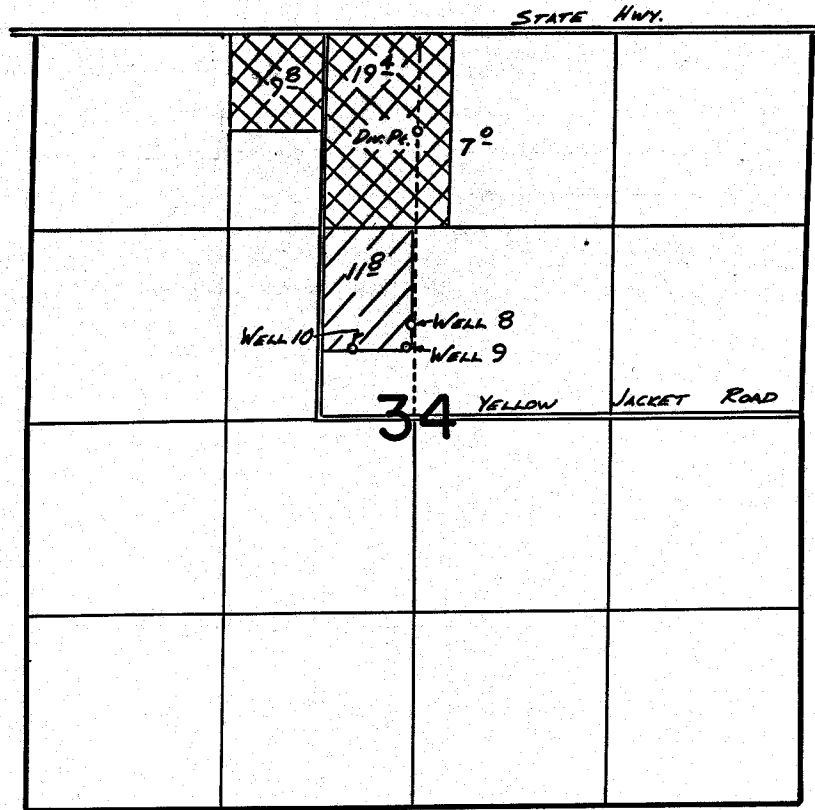

WELL 8 Loc: 640' N + 20' W. From Center Sec 34  
 WELL 9 Loc: 500' N. + 30' W. From Center Sec. 34  
 WELL 10 Loc: 490' N. + 430' W. From Center Sec 34

## FINAL PROOF SURVEY UNDER

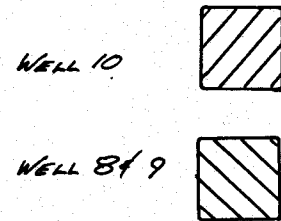

Application No. G-7926... Permit No. G-7392...  
 IN NAME OF

James A. Reese

Surveyed Oct. 8, 1980, by V. Church