


G 8591

55622

T. 5N., R. 29E., W.M

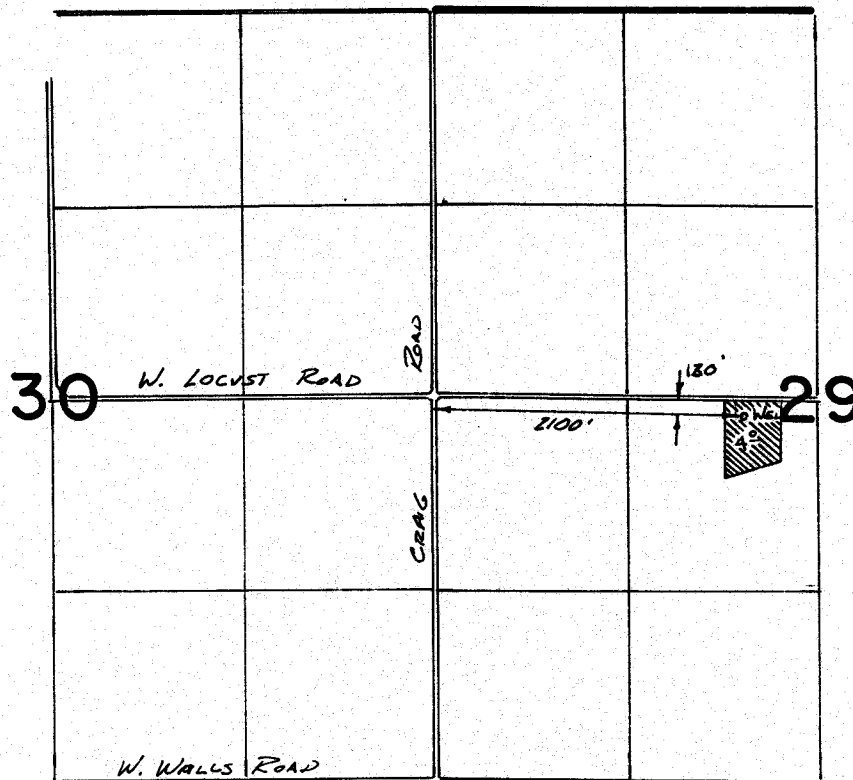

**FINAL PROOF SURVEY**  
 UNDER

Application No. **G:9259** Permit No. **G:8591**...  
 IN NAME OF

...**RICHARD J. & DONNA L. REDDINGTON**

Surveyed **4-20**..... **1983**, by *W.L. Church*...