


T.1S. R.13E. W.M.

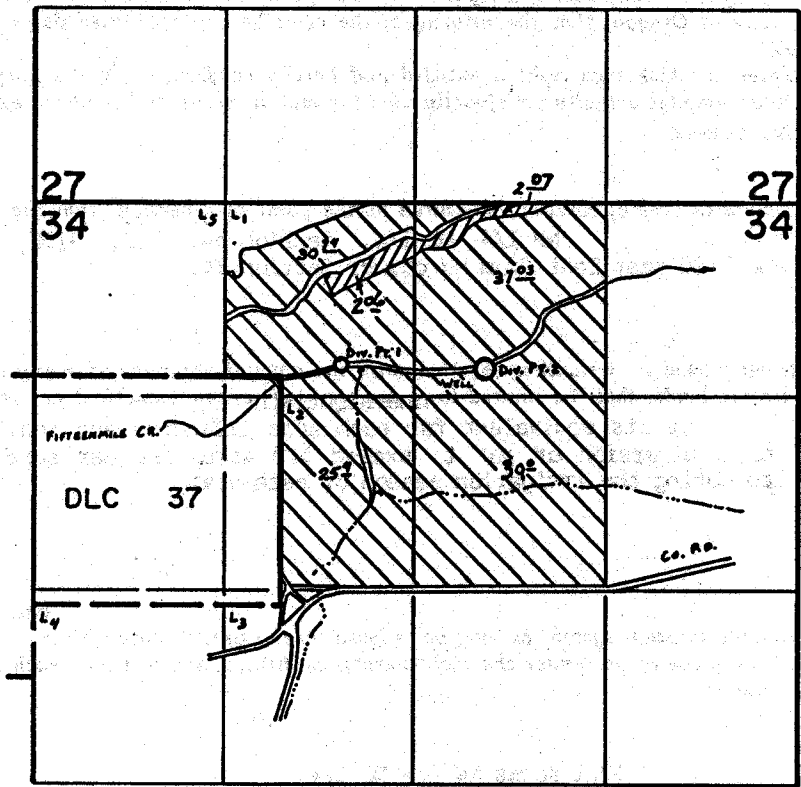

WELL LOC: 1150' S. & 3120' E.
 DIV. PTS. LOC: #1 - 1130' S. & 2150' E. } ALL FROM N.W. COR SEC. 34.
 #2 - 1100' S. & 3120' E. }
 ▨ - PRIMARY IRR. (APP. 56697) SUR. IRR. (APP. G-8461)
 ▩ - SUPP. IRR. (APP. G-8461)

FINAL PROOF SURVEY UNDER

G-8461 G-8176
 Application No. 56647. Permit No. 43251.....
 IN NAME OF

KENNETH PURDOM

Surveyed June 26, 1979, by C.L. HUGHES.....